

TIPPACH  
M 2013

MISSISSIPPI  
BOARD OF WATER COMMISSIONERS  
416 North State Street  
Jackson, Mississippi 39201

WATER WELL DRILLERS LOG

Oct  
date well completed

1989 LEOPER Drilling  
firm name

Tippach  
county well located

LANDOWNER: Gerard Ordman  
Rt 1 Blue Mt, MS  
(mailing address)

WELL LOCATION:  
sec 2 T S N R 2 (E)  
3 miles NW of Blue Mt  
(distance) (direction) (nearest town)

WELL PURPOSE: Home  
(home, irrigation, municipal, industrial)

WELL COMPLETION DATA:

(1) diameter (inches) 4"

(2) total depth (feet) 490

(3) static water level (feet) 140 below top of ground.

(4) casing Pvc 260'  
(material) (depth)  
4" If telescope see back.  
(size)

(5) screen NONE  
(length) (depth to top)  
(size) (material)

(6) pump 1 10  
(HP) (yield gpm)  
Elec  
(type power)

(7) electric log NO  
(yes or no)  
(organization running log)

(8) how well bottom plugged OPEN

description of formations encountered	from	to
<u>TOP Clay</u>	<u>0</u>	<u>20</u>
<u>Red Sand</u>	<u>20</u>	<u>100</u>
<u>Blue Clay</u>	<u>100</u>	<u>260</u>
<u>Chalk</u>	<u>260</u>	<u>430</u>
<u>SAND</u>	<u>430</u>	<u>490</u>

RECEIVED


NOV 07 1989

Department of Natural Resources  
Bureau of Land & Water Resources

DRILLERS REMARKS:

If well telescopes please sketch and show depths.

GROUND LEVEL

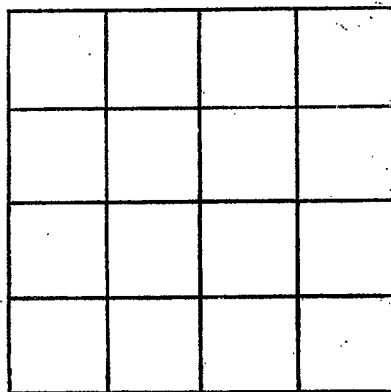

SECTION \_\_\_\_\_

Please indicate well location X.

ADDITIONAL INFORMATION

If more than one screen, show locations of each on sketch.