

MISSISSIPPI DEPARTMENT OF NATURAL RESOURCES

Bureau of Land and Water Resources

P.O. Box 10631

Jackson, Mississippi 39209

WATER WELL DRILLERS LOG

COUNTY WELL LOCATED <u>Tippah</u>	
WELL NUMBER <u>M</u>	CODED
DATE WELL COMPLETED <u>2014</u> <u>5-1-88</u>	

PERMIT NUMBER
NAME OF DRILLING FIRM <u>Medlin Well Drilling</u>

NAME & MAILING ADDRESS OF LANDOWNER <u>Sybil Harkness</u> <u>Blue Mtn.</u>			
WELL LOCATION: SEC	TOWNSHIP	RANGE	
<u>100</u>	<u>5 N</u>	<u>2</u>	<u>W</u>
DISTANCE	DIRECTION	NEAREST TOWN	
<u>3</u>	<u>West</u>	<u>Blue Mtn</u>	
OTHER LANDMARK <u> Hwy 2</u>			
WELL PURPOSE (Home Irrigation, Municipal, Industrial, Fish Pond, etc.) <u>Home Irrigation</u>			

PUMP DATA		
PUMP TYPE (Circle One): <u>Submersible</u> Turbine, Jet, Flowing Well, Other (Describe) _____		
POWER TYPE (Circle One): <u>Electric</u> Tractor, Diesel, Gasoline <u>3/4</u> Butane, Other (Describe) _____ H/P		
Pump Capacity (GPM)	No. of Stages	Setting Depth FT.
PUMP TEST		
Well yielded _____ GPM with a drawdown of _____ ft. after _____ hours of pumping		

WELL DATA		
Well Depth <u>210'</u>	Casing Diameter (in.) <u>4"</u>	Casing Length (Ft.) <u>210'</u>
Type of Casing <u>PVC</u>	Hole Depth	Depth to Static Water Level
TYPE OF COMPLETION: (Circle One or More): <u>Gravel Packed</u> Underreamed, Telescoped, Natural Development, Open Hole, Other (Describe) _____		
Top of Lap Pipe or Reduction in Casing FEET IF TELESCOPED OR MORE THAN ONE SCREEN: USE BACK PAGE		

LOG DATA	
TYPE OF LOG RUN (Circle One): No Log Run, Electric, Gamma Ray, Density, Sonic, Neutron, Other (Describe) _____	
Name of Organization Running Log	

SCREEN DATA		
Diameter - Inches	Length - Feet	Slot Size - Inches
Screen Type	Depth to Bottom - Feet	

GEOLOGIC DATA (Office Use Only)			
Surface Elev.	Geologic Unit	Unit Thickness	Depth to Top
Subs. SWL	Date	Analysis	Aquifer Test

Driller's Remarks
RECEIVED
SEP 28 1989


DESCRIPTION OF FORMATIONS ENCOUNTERED	FROM	TO
<u>Top Soil</u>	<u>0</u>	<u>120</u>
<u>Rock & Clay</u>	<u>120-180</u>	
<u>Sand & Aquifer</u>	<u>180</u>	<u>210</u>

FORMATIONS (Continued)	FROM	TO
Department of Natural Resources		
Bureau of Land & Water Resources		

IF MORE SPACE IS NEEDED, USE BACK

If well telescopes please
sketch and show depths.

GROUND LEVEL

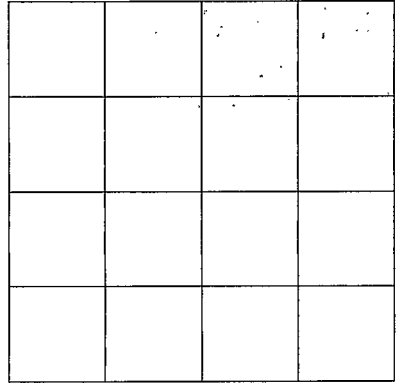

SECTION _____

Please indicate well location X.

ADDITIONAL INFORMATION

If more than one screen,
show location of each on sketch.