

MISSISSIPPI DEPARTMENT OF ENVIRONMENTAL QUALITY

Office of Land and Water Resources

P. O. Box 10631
Jackson, MS 39289-0631
WATER WELL DRILLERS LOG

COUNTY WELL LOCATED TIPPICAH	
WELL NUMBER 7/A 2017	CODED
DATE WELL COMPLETED 7-28-98	

PERMIT NUMBER
NAME OF DRILLING FIRM Muell

NAME & MAILING ADDRESS OF LANDOWNER Coombs Angus Farm			
Blue Mtms MS 38610			
WELL LOCATION: SEC 11 TOWNSHIP S RANGE 2 E W			
DISTANCE 2 Miles		DIRECTION W of Blue mtms	
OTHER LANDMARK			
WELL PURPOSE: <input checked="" type="checkbox"/> Home Irrigation, <input type="checkbox"/> Municipal, <input type="checkbox"/> Industrial, <input type="checkbox"/> Fish Pond, etc.			

PUMP DATA		
PUMP TYPE (Circle One): <input checked="" type="checkbox"/> Submersible, <input type="checkbox"/> Turbine, <input type="checkbox"/> Jet, <input type="checkbox"/> Flowing Well, Other (Describe)		
POWER TYPE (Circle One): <input checked="" type="checkbox"/> Electric, <input type="checkbox"/> Tractor, <input type="checkbox"/> Diesel, <input type="checkbox"/> Gasoline, <input type="checkbox"/> Butane, Other (Describe) H/P 1		
Pump Capacity (GPM) 15	No. of Stages	Setting Depth 180' FT.
PUMP TEST		
Well yielded 15 GPM with a drawdown of 8 ft. after 8 hours of pumping		


WELL DATA		
Well Depth 340'	Casing Diameter (In.) 4"	Casing Length (Fl.) 340
Type of Casing PVC	Hole Depth 340	Depth to Static Water Level 120'
TYPE OF COMPLETION: (Circle One or More): <input checked="" type="checkbox"/> Gravel Packed, <input type="checkbox"/> Underreamed, <input type="checkbox"/> Telescoped, <input type="checkbox"/> Natural Development, <input type="checkbox"/> Open Hole, <input type="checkbox"/> Other (Describe)		
WELL GROUTED TO A DEPTH OF 25 FEET Type Grout (circle one) <input checked="" type="checkbox"/> Cement, <input type="checkbox"/> Bentonite, or <input type="checkbox"/> Mix		

LOG DATA	
TYPE OF LOG RUN (Circle One): <input type="checkbox"/> No Log Run, <input type="checkbox"/> Electric, <input type="checkbox"/> Gamma Ray, <input type="checkbox"/> Density, <input type="checkbox"/> Sonic, <input type="checkbox"/> Neutron, Other (Describe)	
Name of Organization Running Log	

SCREEN DATA		
Diameter - Inches 4"	Length - Feet 20	Slot Size - Inches 013
Screen Type PVC	Depth to Bottom - Feet 320, 340	


GEOLOGIC DATA (Office Use Only)			
Surface Elev.	Geologic Unit	Unit Thickness	Depth to Top
Subs. SWL	Date	Analysis	Aquifer Test
Driller's Remarks			
Top of Lap Pipe or Reduction in Casing			
FEET IF TELESCOPED OR MORE THAN ONE SCREEN: USE BACK PAGE			

DESCRIPTION OF FORMATIONS ENCOUNTERED	FROM	TO
top soil	0	100
white clay, sand mix		
shell rock, hard	100	240
clay rock		
rock, sand	240	340
aquifer		

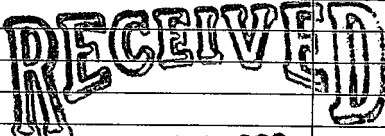FORMATIONS (Continued)	FROM	TO
 MAY 28 1999 Dept of Environmental Quality Office of Land & Water Resources		
IF MORE SPACE IS NEEDED, USE BACK		

If well telescopes please sketch and show depths.

GROUND LEVEL

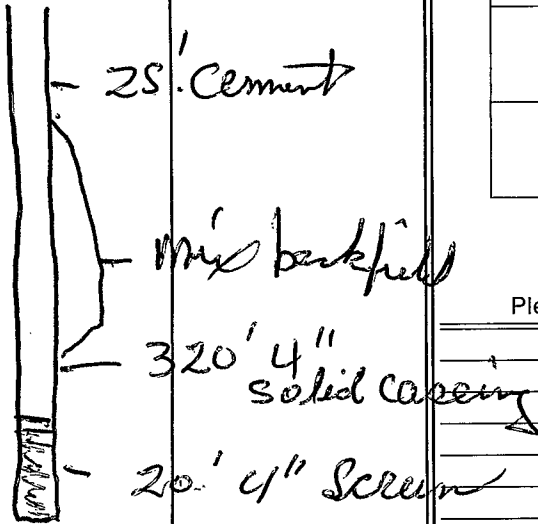

	X 11		

Blue Note

SECTION _____

Please indicate well location X.

ADDITIONAL INFORMATION

If more than one screen, show location of each on sketch.