

Tippah
 M 2020
 5-24-70

MISSISSIPPI
 BOARD OF WATER COMMISSIONERS
 416 North State Street
 Jackson, Mississippi 39201

WATER WELL DRILLERS LOG

524 19 70 J T Madlin Tippah
 date well completed firm name county/well located

LANDOWNER: Jane Madres

description of formations encountered	from	to
Clay	0	16
red sand	16	52
blue clay	52	118
Rock	118	129
blue "	129	161
sand	161	176
blue "	176	207
sand	207	224
blue "	224	260
blue "	260	269
Rock	269	301
sand	301	305
blue "	305	309
sand	309	329
blue "	329	360
sand	360	368

(mailing address) 216

WELL LOCATION:
 sec 36 T 5 N R 2 E
 5 miles (distance) S (direction) of Blue Mtn (nearest town)

WELL PURPOSE:
 (home, irrigation, municipal, industrial)

WELL COMPLETION DATA:

- (1) diameter (inches) 5
- (2) total depth (feet) 57
- (3) static water level (feet) 20 below top of ground
- (4) casing (material) P (depth) (size) if telescope see back.
- (5) screen 0 (length) (depth to top) (size) (material)
- (6) pump 6 (HP) (yield gpm) (type power) E
- (7) electric log (yes or no) (organization running log)
- (8) how well bottom plugged


JUN 3 1970

DRILLERS REMARKS:

MISS. BD. OF
 WATER COMM.

If well telescopes please sketch and show depths.

GROUND LEVEL

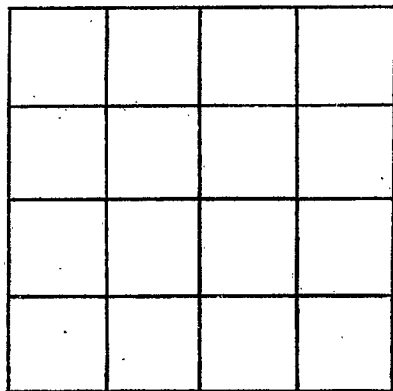

SECTION _____

Please indicate well location X.

ADDITIONAL INFORMATION

If more than one screen,
show locations of each on sketch.