

Lippah
N 13
6-15-68

MISSISSIPPI-
 BOARD OF WATER COMMISSIONERS
 416 North State Street
 Jackson, Mississippi 39201

CODED

WATER WELL DRILLERS LOG

6-15-1967 date well completed
 Jump Well Co firm name
 Lippah county well located

LANDOWNER:
 Frank Strickland
 Blue Mt. Miss
 (mailing address)

description of formations encountered	from	to
micke. clay	0	200
rock + sand	200	300

WELL LOCATION:
 sec 30 T 5 N R 3 E
 S #
 4 miles So. of Blue Mt.
 (distance) (direction) (nearest town)

WELL PURPOSE: home
 (home, irrigation, municipal, industrial)

CODED

- WELL COMPLETION DATA:
- (1) diameter (inches) 4"
 - (2) total depth (feet) 300
 - (3) static water level (feet) 40 below top of ground.
 - (4) casing PVC, 100
 (material) (depth)
4" if telescope see back.
 (size)
 - (5) screen None, -0
 (length) (depth to top)
0 (size) 0 (material)
 - (6) pump 3/4, 7
 (HP) (yield gpm)
Elec.
 (type power)
 - (7) electric log NO
 (yes or no)
0
 (organization running log)
 - (8) how well bottom plugged 0


DRILLERS REMARKS:

DEC 10 1968

MISS. BD. ON
 WATER COM.

If well telescopes please sketch and show depths.

GROUND LEVEL

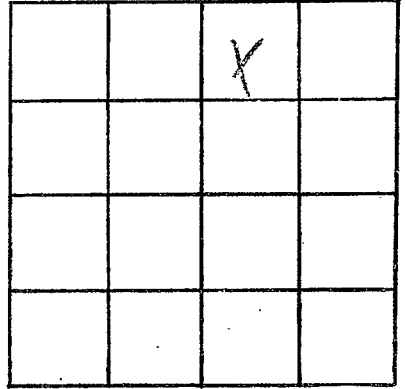

SECTION 30

Please indicate well location X.

ADDITIONAL INFORMATION

If more than one screen, show locations of each on sketch.