

MISSISSIPPI
BOARD OF WATER COMMISSIONERS
416 North State Street
Jackson, Mississippi 39201

CODED

WATER WELL DRILLERS LOG

7-12-19
date well completed

Ed Jumper Well Co.
firm name

Tippah
county well located

LANDOWNER:

Ruby Cook
Blue Mtn, Miss.
(mailing address)

description of formations encountered

from to

WELL LOCATION:

sec 22 T. 5 N. R. 3 E
S
4 miles E of Blue Mtn
(distance) (direction) (nearest town)

WELL PURPOSE:

Home
(home, irrigation, municipal, industrial)

WELL COMPLETION DATA:


- (1) diameter (inches) 4"
- (2) total depth (feet) 220
- (3) static water level (feet) 50 below top of ground.
- (4) casing PVC 90 (material), (depth), 4' (size) if telescope see back.
- (5) screen 0 (length), 0 (depth to top), 0 (size), 0 (material)
- (6) pump 1/2 (HP), 7 (yield gpm), Elec (type power)
- (7) electric log no (yes or no), 0 (organization running log)
- (8) how well bottom plugged 0

CODED

DRILLERS REMARKS:

DEC 10 1968

MISS. BD. OF
WATER COMMISSIONERS

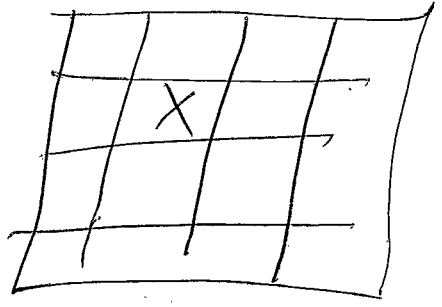

22