

Zippah
N 16
12-7-68

MISSISSIPPI
 BOARD OF WATER COMMISSIONERS
 416 North State Street
 Jackson, Mississippi 39201

CODED

WATER WELL DRILLERS LOG

12-7-68 19 Jump Well Co. Zippah
 date well completed firm name county well located

LANDOWNER:
Doe Vent Corp.
Blue Mtn, Miss
 (mailing address)

description of formations encountered	from	to
<u>CLAY</u>	<u>0</u>	<u>100</u>

WELL LOCATION:
 sec 7 T 5 R 3 E
1 miles So. of Blue Mtn.
 (distance) (direction) (nearest town)

<u>ROCK + SAND</u>	<u>100</u>	<u>350</u>
--------------------	------------	------------

WELL PURPOSE: industrial
 (home, irrigation, municipal, industrial)

CODED

WELL COMPLETION DATA:

(1) diameter (inches) 6"

(2) total depth (feet) 350 ft.

(3) static water level (feet) 40 below
 top of ground. above

(4) casing Steel 350
 (material) (depth)
5"
 (size) if telescope see back.

(5) screen 40 ft. 300'
 (length) (depth to top)
4" steel
 (size) (material)

(6) pump 1 H.P. 15
 (HP) (yield gpm)
2 Lec
 (type power)

(7) electric log No
 (yes or no)
0
 (organization running log)

(8) how well bottom plugged lid

APR - 9 1968


MISS. Bd. OF
 WATER COMMISSIONERS

DRILLERS REMARKS:

(1)

If well telescopes please sketch and show depths.

GROUND LEVEL

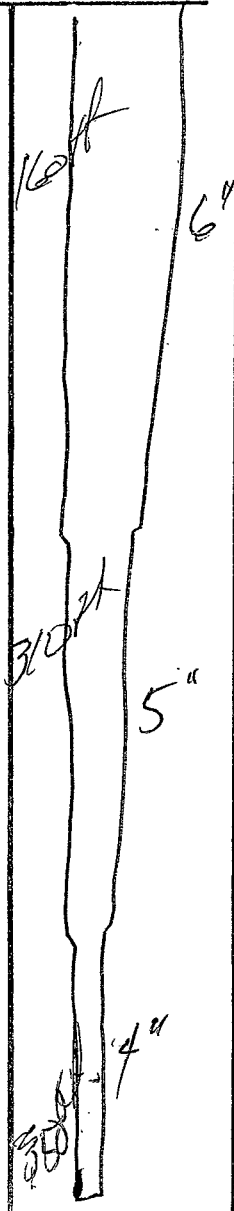

X			

SECTION 7

Please indicate well location X.

ADDITIONAL INFORMATION

Lined area for additional information.

If more than one screen, show locations of each on sketch.