

Tippah Co
 N 20
 4-10-70

MISSISSIPPI
 BOARD OF WATER COMMISSIONERS
 416 North State Street
 Jackson, Mississippi 39201

WATER WELL DRILLERS LOG

4-10-1970 date well completed
 J. J. Medlin firm name
 Tippah county well located

LANDOWNER: R. A. Bishop
 R#2 Blue water
 Miss
 (mailing address)

description of formations encountered	from	to
White clay	0	12
yellow clay	12	40
Blue clay	40	118
Sand	118	136
Blue	136	163
Samel	163	198
Blue	198	235

WELL LOCATION:
 sec 22 T 5 N R 3 E
 4 miles NE of Cotton
 (distance) (direction) (nearest town)

WELL PURPOSE:
 (home, irrigation, municipal, industrial)

- WELL COMPLETION DATA:
- (1) diameter (inches) 4
 - (2) total depth (feet) 235
 - (3) static water level (feet) 30 below top of ground.
 - (4) casing P 40 (material) (depth)
 - (size) If telescope see back.
 - (5) screen (length) (depth to top)
 - (size) (material)
 - (6) pump 3/4 (HP) 11 (yield gpm)
 - (type power)
 - (7) electric log (yes or no)
 - (organization running log)
 - (8) how well bottom plugged Open


DRILLERS REMARKS:

MAY 5 1970

MISS. Bd. of
 WATER COMMISSIONERS

If well telescopes please sketch and show depths.

GROUND LEVEL

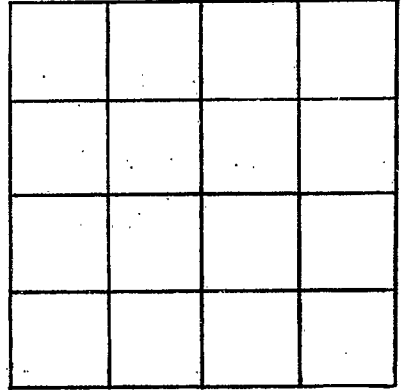

SECTION _____

Please indicate well location X.

ADDITIONAL INFORMATION

If more than one screen,
show locations of each on sketch.