

MISSISSIPPI
BOARD OF WATER COMMISSIONERS
416 North State Street
Jackson, Mississippi 39201

WATER WELL DRILLERS LOG

Tippah
N21
5-28-70

5-28 1970 J T Mellin Tippah
date well completed firm name county well located

LANDOWNER: W
W. L. Hughes
Blue Water
(mailing address) 216

description of formations encountered	from	to
clay	0	12
Rock	12	43
Blue clay	43	108
Sand	108	128
Rock	128	134
Blue "	134	178
Sand	178	215
Blue "	215	220

WELL LOCATION:
sec. 5 T. 5 N. R. 3 E.
4 miles W of Blue Water
(distance) (direction) (nearest town)

WELL PURPOSE:
(home, irrigation, municipal, industrial)


- WELL COMPLETION DATA:
- (1) diameter (inches) 4
 - (2) total depth (feet) 220
 - (3) static water level (feet) 2 below above top of ground.
 - (4) casing 15 (material) (depth)
_____ if telescope see back.
(size)
 - (5) screen _____ (length) (depth to top)
(size) (material)
 - (6) pump none (HP) (yield gpm)
(type power)
 - (7) electric log (yes or no) _____
(organization running log) _____
 - (8) how well bottom plugged _____

JUN 3 1970

DRILLERS REMARKS:

If well telescopes please
sketch and show depths.

GROUND LEVEL

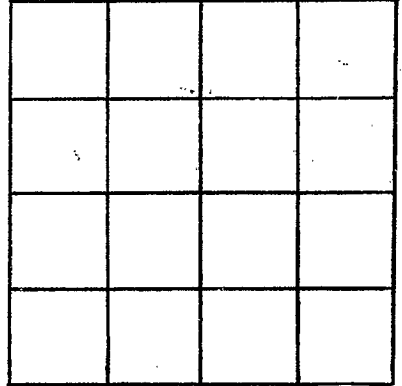

SECTION _____

Please indicate well location X.

ADDITIONAL INFORMATION

If more than one screen,
show locations of each on sketch.