

TIPPAH
N 22
9-16-70

MISSISSIPPI
BOARD OF WATER COMMISSIONERS
416 North State Street
Jackson, Mississippi 39201

CODED

WATER WELL DRILLERS LOG

9 16 19 70
date well completed

J T Madlin
firm name

Tippah
county well located

LANDOWNER: Mrs George
Thomas R # 3
Blue Mtn
(mailing address)

| Description of formations encountered | from | to |
|---------------------------------------|------|-----|
| Chert | 0 | 11 |
| Red Sand | 11 | 27 |
| Rock | 27 | 33 |
| Clay | 33 | 60 |
| Blue Clay | 60 | 130 |
| Rock | 130 | 138 |
| Sand | 138 | 146 |
| Rock | 146 | 153 |
| Sand | 153 | 172 |
| Blue | 172 | 185 |

WELL LOCATION:
sec 2 T 3 N R 3 E
5 miles E of Blue Mtn
(distance) (direction) (nearest town)

WELL PURPOSE:
(home, irrigation, municipal, industrial)

WELL COMPLETION DATA:

- (1) diameter (inches) 4
- (2) total depth (feet) 185
- (3) static water level (feet) 70 below above top of ground.
- (4) casing P 80
(material) (depth)
(size) If telescope see back.
- (5) screen 20 16
(length) (depth to top)
(size) (material)
- (6) pump 1/2 8
(HP) (yield gpm)
E
(type power)
- (7) electric log (yes or no) _____
(organization running log) _____
- (8) how well bottom plugged _____

CODED


OCT 7 1970

DRILLERS REMARKS:

MISS. BD. OF
WATER COMM.

If well telescopes please sketch and show depths.

GROUND LEVEL

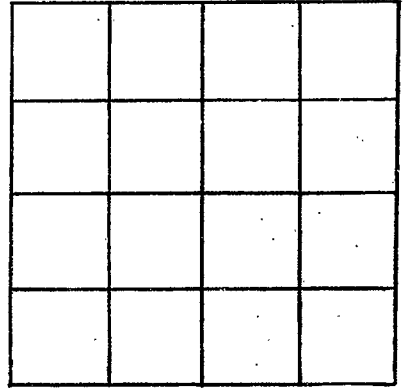

SECTION _____

Please indicate well location X.

ADDITIONAL INFORMATION

If more than one screen,
show locations of each on sketch.