

TIPPAH
 N24
 3-7-70

MISSISSIPPI
 BOARD OF WATER COMMISSIONERS
 416 North State Street
 Jackson, Mississippi 39201

CODED

WATER WELL DRILLERS LOG

3-7-1970 date well completed
 Jumper Well Drilling firm name
 Tippah county well located

LANDOWNER:
 Joe L Spight
 Blue mtn, miss
 (mailing address)

description of formations encountered	from	to
C. Layer	0	50
Clay & Rocks	50	150
Rocks & Sand	150	200

WELL LOCATION:
 sec 22 T 5 N R 3 E
 4 miles E of Blue mtn
 (distance) (direction) (nearest town)

WELL PURPOSE: Home
 (home, irrigation, municipal, industrial)

- WELL COMPLETION DATA:
- (1) diameter (inches) 4"
 - (2) total depth (feet) 220
 - (3) static water level (feet) 50 below above top of ground.
 - (4) casing PVC 90
 (material) (depth)
4" If telescope see back.
 (size)
 - (5) screen 0 0
 (length) (depth to top)
0 0
 (size) (material)
 - (6) pump 1/2 7
 (HP) (yield gpm)
Elec
 (type power)
 - (7) electric log NO
 (yes or no)
0
 (organization running log)
 - (8) how well bottom plugged 0

CODED


JUN 25 1971

MISS. BD. OF
 WATER COMM.

DRILLERS REMARKS:

If well telescopes please sketch and show depths.

GROUND LEVEL

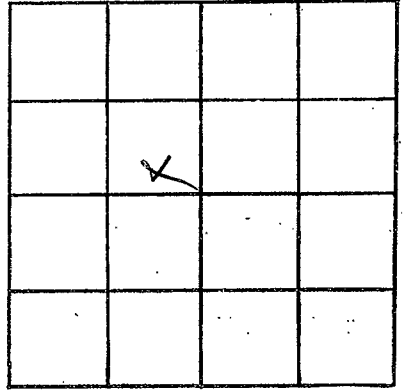

SECTION 22

Please indicate well location X.

ADDITIONAL INFORMATION

If more than one screen,
show locations of each on sketch.