

TIPPAM  
 N25  
 9-1-70

MISSISSIPPI  
 BOARD OF WATER COMMISSIONERS  
 416 North State Street  
 Jackson, Mississippi 39201

**CODED**

WATER WELL DRILLERS LOG

9-1 1970 Jumper Well Drilling Tippah  
 date well completed firm name county well located

LANDOWNER:  
 BRYAN ELLIOTT, JR.  
 Blue mtn, Miss  
 (mailing address)

description of formations encountered	from	to
Mixed CLAY	0	90
CLAY	90	300
SAND + ROCK	300	400

WELL LOCATION:  
 sec. 31 T. 5 S. R. 3 E.  
 2 miles W of C. H. N. PLANT  
 (distance) (direction) (nearest town)

WELL PURPOSE: Home  
 (home, irrigation, municipal, industrial)

WELL COMPLETION DATA:

(1) diameter (inches) 4"

(2) total depth (feet) 400

(3) static water level (feet) 70 below top of ground.

(4) casing PVC, 120, (material) (depth)  
 0 (size) if telescope see back.

(5) screen 0 (length) 0 (depth to top)  
 0 (size) 0 (material)

(6) pump 3/4 (HP) 8 (yield gpm)  
 Elec- (type power)

(7) electric log 0 (yes or no)  
 0 (organization running log)

(8) how well bottom plugged 0

**CODED**


JUN 25 1971

DRILLERS REMARKS:

MISS. BD. OF  
 WATER COMMISSIONERS

If well telescopes please sketch and show depths.

GROUND LEVEL

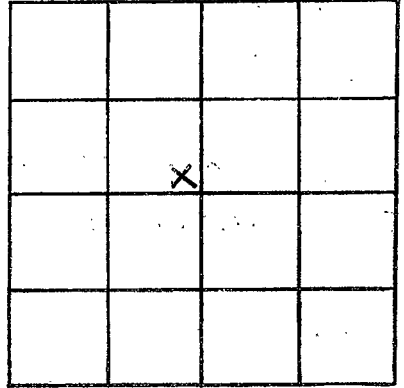

SECTION 31

Please indicate well location X.

ADDITIONAL INFORMATION

If more than one screen,  
show locations of each on sketch.