

TIPPAH
N26
5-17-71

MISSISSIPPI
BOARD OF WATER COMMISSIONERS
416 North State Street
Jackson, Mississippi 39201

CODED

WATER WELL DRILLERS LOG

8-17 1971 Jumpes Well Del Tippan
date well completed firm name county well located

LANDOWNER:

Oscar Bond
Blue Mt. Miss
Ripley Miss
(mailing address)

description of formations encountered

from to

Mixed Sand & Clay 0 40
Clay 40 500
Rock + water bearing sand 300 feet

WELL LOCATION:

sec. 31 T. 5 N. R. 3 E
2 miles N of Cotton Plant
(distance) (direction) (nearest town)

WELL PURPOSE:

(home, irrigation, municipal, industrial)

WELL COMPLETION DATA:

- (1) diameter (inches) 4
- (2) total depth (feet) 400
- (3) static water level (feet) 60 below top of ground.
- (4) casing pre 80
(material) (depth)
4 if telescope see back.
(size)
- (5) screen 0 0
(length) (depth to top)
0 (size) (material)
- (6) pump 3/4 8
(HP) (yield gpm)
elec.
(type power)
- (7) electric log —
(yes or no)
(organization running log)
- (8) how well bottom plugged —

CODED


JUN 25 1971

DRILLERS REMARKS:

MISS. BD. OF
WATER COMM.

If well telescopes please sketch and show depths.

GROUND LEVEL

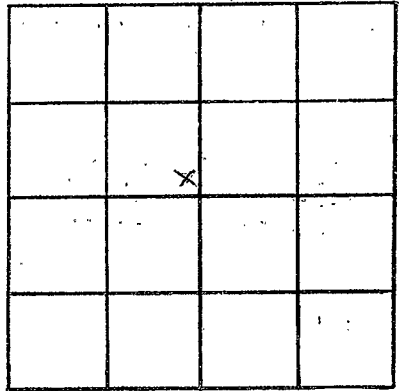

SECTION 31

Please indicate well location X.

ADDITIONAL INFORMATION

If more than one screen, show locations of each on sketch.