

TIPPAH
N31
9-15-72

MISSISSIPPI
BOARD OF WATER COMMISSIONERS
416 North State Street
Jackson, Mississippi 39201

20000
4500
24300

WATER WELL DRILLERS LOG

CODED

9 15 1972 J T Modlin Tippeah
date well completed firm name county well located

LANDOWNER:	description of formations encountered	from	to
<i>Wenson</i> Blue water R # 1. (mailing address)	Clay Silt SAND & SAND	0	18 18 160 230
WELL LOCATION: sec <u>31</u> T <u>5</u> N R <u>3</u> E <u>3</u> miles <u>S</u> of <u>Blue water</u> (distance) (direction) (nearest town)			
WELL PURPOSE: (home, irrigation, municipal, industrial)			
WELL COMPLETION DATA:			
(1) diameter (inches) <u>4</u>			
(2) total depth (feet) <u>250</u>			
(3) static water level (feet) <u>95</u> below above top of ground.			
(4) casing <u>F</u> <u>100</u> (material) (depth) (size) if telescope see back.			
(5) screen <u> </u> <u> </u> (length) (depth to top) (size) (material)			
(6) pump <u>15</u> <u>6</u> (HP) (yield gpm) <u>E</u> (type power)			
(7) electric log <u> </u> (yes or no) (organization running log)			
(8) how well bottom plugged: <u>0</u>			
DRILLERS REMARKS:			


CODED

OCT 12 1972

MISS. BD. OF
WATER COMMISSIONERS

If well telescopes please sketch and show depths.

GROUND LEVEL

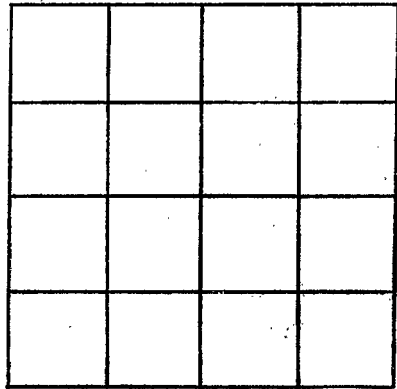

SECTION _____

Please indicate well location X.

ADDITIONAL INFORMATION

If more than one screen,
show locations of each on sketch.