

TIPPAH
N32
9-19-72

MISSISSIPPI
BOARD OF WATER COMMISSIONERS
416 North State Street
Jackson, Mississippi 39201

460.00
\$ 23.00
\$ 3.00
CODED

WATER WELL DRILLERS LOG

9 19 1972
date well completed

JT Medlin
firm name

TIPPAH
county well located

LANDOWNER:	description of formations encountered	from	to
Wayne Hughey Blue Mt RD 2. (mailing address)	clay " " & Beach sand & Beach	0 15 102	15 107 160
WELL LOCATION: sec. 3 T 5 N R 3 E 4 miles NE of Blue Mt (distance) (direction) (nearest town)			
WELL PURPOSE: (home, irrigation, municipal, industrial)			
WELL COMPLETION DATA:			
(1) diameter (inches) 4			
(2) total depth (feet) 160			
(3) static water level (feet) 32 below top of ground.			
(4) casing P, 160 (material) (depth)			
(size) If telescope see back.			
(5) screen 10, 150 (length) (depth to top)			
4, P (size) (material)			
(6) pump 3/4, 6 (HP) (yield gpm)			
E (type power)			
(7) electric log (yes or no)			
(organization running log)			
(8) how well bottom plugged			
DRILLERS REMARKS:			

network well


CODED

NOV 10 1972

MISS. ED. CENTER

If well telescopes please sketch and show depths.

GROUND LEVEL

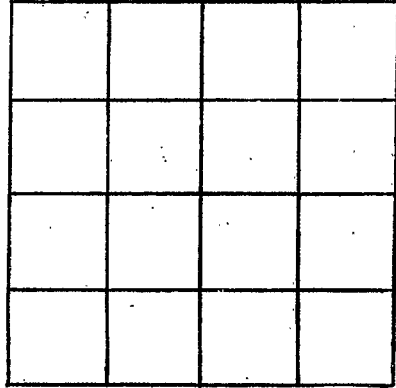

SECTION _____

Please indicate well location X.

ADDITIONAL INFORMATION

If more than one screen,
show locations of each on sketch.