

TIPPAH
 N 33
 11-10-71

MISSISSIPPI
 BOARD OF WATER COMMISSIONERS
 416 North State Street
 Jackson, Mississippi 39201

WATER WELL DRILLERS LOG

11-10-71 19 *Jumpwell Drilling* *Tipah*
 date well completed firm name county well located

LANDOWNER:
Noveta Simmons
Blue Mountain
 (mailing address)

description of formations encountered	from	to
<i>mix of clay</i>	<i>0</i>	<i>180</i>
<i>sand & rock</i>	<i>180</i>	<i>250</i>

WELL LOCATION:
 sec *22* 5 R *3* E
4 miles *E* of *Blue Mt*
 (distance) (direction) (nearest town)

WELL PURPOSE: *home*
 (home, irrigation, municipal, industrial)


- WELL COMPLETION DATA:
- (1) diameter (inches) *4"*
 - (2) total depth (feet) *250*
 - (3) static water level (feet) *70* below top of ground.
 - (4) casing *PVC* *170*
 (material) (depth)
4" (size) if telescope see back.
 - (5) screen *0* *0*
 (length) (depth to top)
0 (size) *1/2* (material)
 - (6) pump *1/2* *4*
 (HP) (yield gpm)
Elex
 (type power)
 - (7) electric log *No*
 (yes or no)
 - (organization running log) *2*
 - (8) how well bottom plugged *0*

NOV 20 1971

DRILLERS REMARKS:

If well telescopes please sketch and show depths.

GROUND LEVEL

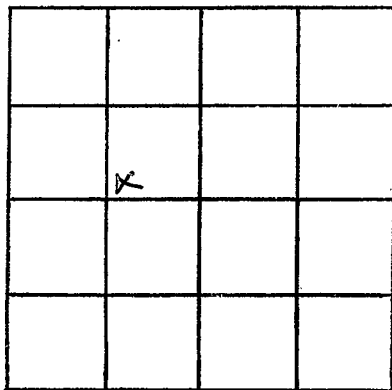

SECTION 22

Please indicate well location X.

ADDITIONAL INFORMATION

Lined area for additional information.

If more than one screen, show locations of each on sketch.