

TIPPAH
 N 34
 12-8-71
 12-8-71
 date well completed

MISSISSIPPI
 BOARD OF WATER COMMISSIONERS
 416 North State Street
 Jackson, Mississippi 39201

WATER WELL DRILLERS LOG


Jumper Well Drilling
 firm name
 Tippah
 county well located

LANDOWNER:	description of formations encountered	from	to
Annie Edgington <small>(mailing address)</small>	Mud & Clay	0	150
sec. 22 T. 5 N. R. 3 E. 4 miles E Blum Mt. <small>(distance) (direction) (nearest town)</small>	Sand & rock	180	250
WELL LOCATION: (home, irrigation, municipal, industrial)			
WELL PURPOSE: Home			
WELL COMPLETION DATA:			
(1) diameter (inches) 4"			
(2) total depth (feet) 250			
(3) static water level (feet) 70 below top of ground.			
(4) casing PVC 170 <small>(material) (depth)</small>			
4" if telescope see back. <small>(size)</small>			
(5) screen 0 0 <small>(length) (depth to top)</small>			
1/2" (material) <small>(size)</small>			
(6) pump Electr 8 <small>(HP) (yield gpm)</small>			
Clear <small>(type power)</small>			
(7) electric log no <small>(yes or no)</small>			
no <small>(organization running log)</small>			
(8) how well bottom plugged			
DRILLERS REMARKS:			

NOV 20 1972

If well telescopes please sketch and show depths.

GROUND LEVEL

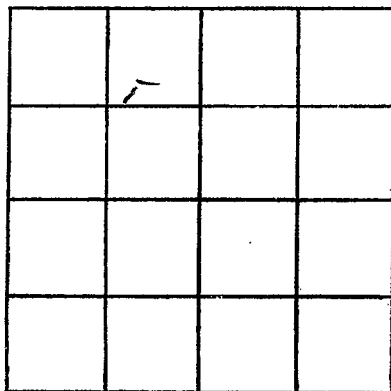

SECTION 22

Please indicate well location X.

ADDITIONAL INFORMATION

If more than one screen,
show locations of each on sketch.