

TIPPAH
N 35
1-28-72

MISSISSIPPI
BOARD OF WATER COMMISSIONERS
416 North State Street
Jackson, Mississippi 39201

WATER WELL DRILLERS LOG

1-28-72 date well completed
Jumper Well Drilling Company firm name
Tippah county well located

LANDOWNER:
Charles Henry Cook
Rt #2 Bud Mt.
(mailing address)

description of formations encountered
mud clay 0-180
sand & rock 180-250

WELL LOCATION:
sec. 22 T. 5 N. R. 3 E.
4 miles E Bud Mt.
(distance) (direction) (nearest town)

WELL PURPOSE: home
(home, irrigation, municipal, industrial)

- WELL COMPLETION DATA:
- (1) diameter (inches) 4"
 - (2) total depth (feet) 250'
 - (3) static water level (feet) 70' below top of ground.
 - (4) casing (material) pc (depth) 120'
4" (size) if telescope see back.
 - (5) screen (length) 0' (depth to top) 0'
(size) (material)
 - (6) pump 1/2 (HP) 8 (yield gpm)
Elec (type power)
 - (7) electric log (yes or no) no
 - (8) how well bottom plugged (organization running log)


NOV 20 1972

MISS. DEPT. OF
WATER CONTROL

DRILLERS REMARKS:

If well telescopes please sketch and show depths.

GROUND LEVEL

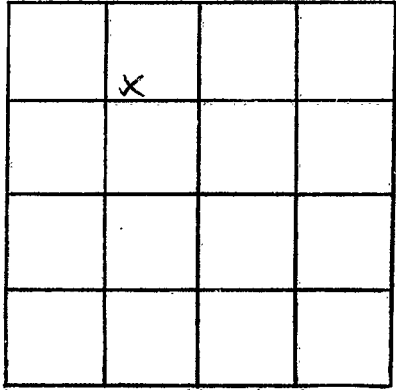

SECTION 22

Please indicate well location X.

ADDITIONAL INFORMATION

If more than one screen, show locations of each on sketch.