

TIPPAH
N 37
7-26-72

MISSISSIPPI
BOARD OF WATER COMMISSIONERS
416 North State Street
Jackson, Mississippi 39201

CODED

WATER WELL DRILLERS LOG

7-26 1972 date well completed
Jumper Deep Dilling firm name
Tippan county well located

LANDOWNER:	description of formations encountered	from	to
Charlie E. Wilson Rt #1 Blue Mountain (mailing address)	Clay	0	50
WELL LOCATION: sec. 22 T 5 N R 3 E 4 miles E of Blue Mt. (distance) (direction) (nearest town)	Clay & Rock	50	150
WELL PURPOSE: <u>Domestic</u> (home, irrigation, municipal, industrial)	Rock & Sand	150	200
WELL COMPLETION DATA: (1) diameter (inches) <u>4"</u> (2) total depth (feet) <u>220</u> (3) static water level (feet) <u>50</u> below above top of ground. (4) casing <u>PVC 90</u> (material) (depth) <u>4"</u> (size) if telescope see back. (5) screen <u>0</u> <u>0</u> (length) (depth to top) <u>0</u> <u>0</u> (size) (material) (6) pump <u>1/2</u> <u>7</u> (HP) (yield gpm) <u>Elec</u> (type power) (7) electric log <u>No</u> (yes or no) <u>0</u> (organization running log) (8) how well bottom plugged <u>0</u>			

CODED


DEC 11 1972

MISS. BD. OF
WATER COMMISSIONERS

DRILLERS REMARKS:

If well telescopes please sketch and show depths.

GROUND LEVEL

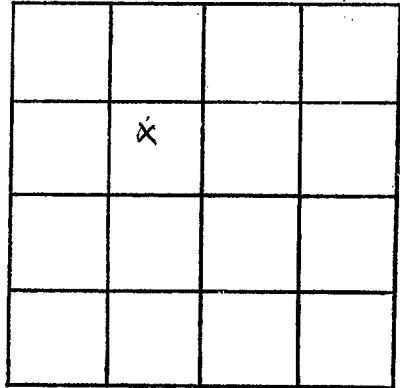

SECTION 22

Please indicate well location X.

ADDITIONAL INFORMATION

Lined area for additional information.

If more than one screen, show locations of each on sketch.