

TIPPAH

~~MISSISSIPPI~~

N 38

7-13-72

7-13-72

date well completed

MISSISSIPPI  
BOARD OF WATER COMMISSIONERS  
416 North State Street  
Jackson, Mississippi 39201

**CODED**

WATER WELL DRILLERS LOG

*Jumpin Well Drilling*  
firm name

*Union*  
county well located

LANDOWNER:	description of formations encountered	from	to
<i>James Dicks</i> <i>RTA1 Blue Mtn.</i> (mailing address)			
WELL LOCATION: sec. <i>28</i> T <i>5</i> N R <i>3</i> E <i>4</i> S <i>8</i> W (distance) miles (direction) of <i>Blue Mtn.</i> (nearest town)	<i>Blue Clay</i>	<i>50</i>	<i>150</i>
WELL PURPOSE: (home, irrigation, municipal, industrial) <i>Home</i>	<i>Rock &amp; Gravel</i>	<i>150</i>	<i>200</i>
WELL COMPLETION DATA: (1) diameter (inches) <i>4"</i>			
(2) total depth (feet) <i>200 ft</i>			
(3) static water level (feet) <i>80</i> below top of ground.			
(4) casing <i>PVC</i> (material) <i>100 ft</i> (depth)			
<i>N</i> (size) If telescope see back.			
(5) screen (length) (depth to top)			
(size) <i>1</i> (material) <i>8</i>			
(6) pump (HP) (yield gpm)			
<i>Elec</i> (type power)			
(7) electric log (yes or no) <i>No</i>			
(organization running log)			
(8) how well bottom plugged <i>0</i>			
DRILLERS REMARKS:			


**CODED**

DEC 11 1972

MISS. BD. OF  
WATER COM. L.

If well telescopes please sketch and show depths.

GROUND LEVEL

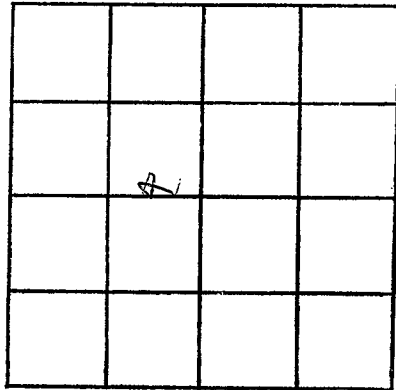

SECTION 22

Please indicate well location X.

ADDITIONAL INFORMATION

If more than one screen,  
show locations of each on sketch.