

MISSISSIPPI
BOARD OF WATER COMMISSIONERS
416 North State Street
Jackson, Mississippi 39201

320.⁰⁰
600
33600

TIPPAH
N39
12-14-72

WATER WELL DRILLERS LOG

12-14 1972
date well completed

J. J. Madhu
firm name

Tipphah
county well located

LANDOWNER:	description of formations encountered	from	to
Charles A. Min. Loren Ripley (mailing address)			
	rock & sand	18	62
	blue clay	62	150
	sand	150	180
WELL LOCATION:			
sec. 36.5 N R. 3 E			
4 miles E of Ripley			
WELL PURPOSE: (home, irrigation, municipal, industrial)			
WELL COMPLETION DATA:			
(1) diameter (inches) 4			
(2) total depth (feet) 180			
(3) static water level (feet) 70 below above top of ground.			
(4) casing (material) P (depth) 150			
(size) if telescope see back.			
(5) screen (length) 0 (depth to top)			
(size) (material)			
(6) pump NO (HP) (yield gpm)			
(type power)			
(7) electric log (yes or no)			
(organization running log)			
(8) how well bottom plugged			


CODED

FEB 5 1973

DRILLERS REMARKS:

If well telescopes please
sketch and show depths.

GROUND LEVEL

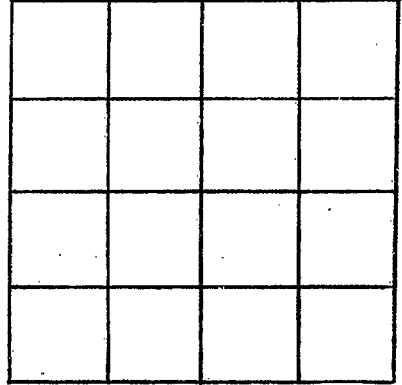

SECTION _____

Please indicate well location X.

ADDITIONAL INFORMATION

If more than one screen,
show locations of each on sketch.