

TIPPAH
 N 40
 2-25-73

MISSISSIPPI
 BOARD OF WATER COMMISSIONERS
 416 North State Street
 Jackson, Mississippi 39201

545 00
 2745
 2245

CODED

WATER WELL DRILLERS LOG

2 25 19 23 J T Medley Tippah
 date well completed firm name county well located

LANDOWNER: Ebenezer Church
 Blue Yew Rd
 (mailing address)

description of formations encountered
 calx rock & sand
 from 0 to 16
 to 140

WELL LOCATION:
 sec. 32-5 N R-30
 1 miles E of Cotton Plant
 (distance) (direction) (nearest town)

WELL PURPOSE:
 (home, irrigation, municipal, industrial)

- WELL COMPLETION DATA:
- (1) diameter (inches) 4
 - (2) total depth (feet) 140
 - (3) static water level (feet) 50 below top of ground
 - (4) casing (material) P (depth) 140
 - (size) if telescope see back.
 - (5) screen (length) 10 (depth to top) 50
 - (size) (material)
 - (6) pump (HP) 1 (yield gpm) 6
 - (type power)
 - (7) electric log (yes or no)
 - (organization running log)
 - (8) how well bottom plugged Cap

CODED


MAR 5 1973

MISS. BD. OF
 WATER COMM.

DRILLERS REMARKS:

If well telescopes please sketch and show depths.

GROUND LEVEL

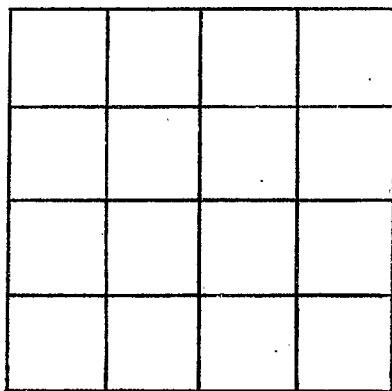

SECTION _____

Please indicate well location X.

ADDITIONAL INFORMATION

If more than one screen, show locations of each on sketch.