

TIPPAH
N 41
2-23-73

MISSISSIPPI **CODED**
BOARD OF WATER COMMISSIONERS
416 North State Street
Jackson, Mississippi 39201

WATER WELL DRILLERS LOG

2-23-73 19 date well completed
Jumper Well Drilling Tippha firm name
Tippha county well located

LANDOWNER:
W. L. Rutherford
Rt #1, Blue Mtn Miss.
(mailing address)

description of formations encountered	from	to
Shale & Clay	0	180

WELL LOCATION:
sec. 22 T 5 N R 3 E
4 miles E of Blue Mtn.
(distance) (direction) (nearest town)

Sand & rock	180	250
-------------	-----	-----

WELL PURPOSE: Home
(home, irrigation, municipal, industrial)

- WELL COMPLETION DATA:
- diameter (inches) 4"
 - total depth (feet) 250'
 - static water level (feet) 70' below top of ground.
 - casing (material) PVC (depth) 120'
4" (size) if telescope see back.
 - screen (length) 0 (depth to top) 0
(size) 1/2 (material) 8
 - pump (HP) 3/4 (yield gpm) 8
(type power) elec
 - electric log (yes or no) 0
(organization running log) 0
 - how well bottom plugged 0


CODED

DRILLERS REMARKS:

APR 2 1973

If well telescopes please sketch and show depths.

GROUND LEVEL

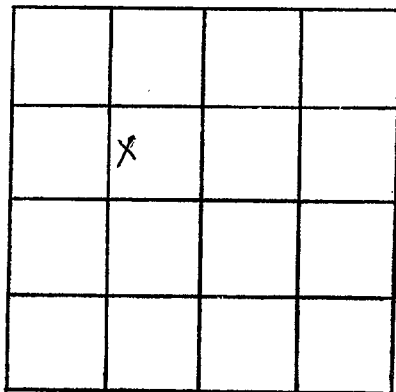

SECTION 22

Please indicate well location X.

ADDITIONAL INFORMATION

Lined area for additional information.

If more than one screen, show locations of each on sketch.