

TIPPAH
 N 42
 5-31-73

MISSISSIPPI
 BOARD OF WATER COMMISSIONERS
 416 North State Street
 Jackson, Mississippi 39201

CODED

WATER WELL DRILLERS LOG

5-31-73 date well completed
 Jumper Well Drilling firm name
 Tippah county well located

LANDOWNER:	description of formations encountered	from	to
Martin J. Green Rt. #1, Blue Mountain (mailing address) Miss.	Mixed Clay	0	50
	Blue Clay	50	150
	Rock + Sand	150	200

LANDOWNER:
 Martin J. Green
 Rt. #1, Blue Mountain
 (mailing address) Miss.

WELL LOCATION:
 sec 22 T 5 N R 3 E
 4 S 8 W
 4 miles 8 of Blue Mtn.
 (distance) (direction) (nearest town)

WELL PURPOSE:
 Home
 (home, irrigation, municipal, industrial)

- WELL COMPLETION DATA:
- (1) diameter (inches) 4"
 - (2) total depth (feet) 200 ft
 - (3) static water level (feet) 80 below top of ground.
 - (4) casing PVC, 100 (material), (depth)
 No (size) if telescope see back.
 - (5) screen 0 (length), 0 (depth to top)
 0 (size), 0 (material)
 - (6) pump 1 (HP), 8 (yield gpm)
 Elec (type power)
 - (7) electric log No (yes or no)
 - (organization running log)
 - (8) how well bottom plugged 0


CODED

DRILLERS REMARKS:

JUN 7 1973

If well telescopes please sketch and show depths.

GROUND LEVEL

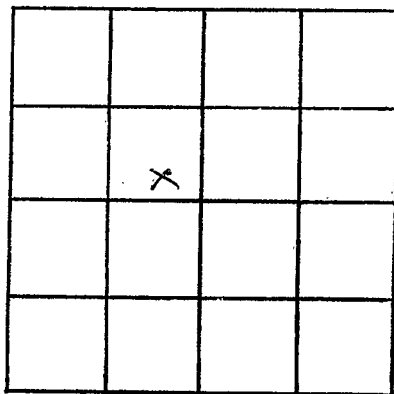

SECTION 22

Please indicate well location X.

ADDITIONAL INFORMATION

Lined area for additional information.

If more than one screen, show locations of each on sketch.