

TIPPAH
N 43
5-16-74

MISSISSIPPI
BOARD OF WATER COMMISSIONERS
416 North State Street
Jackson, Mississippi 39201

CODED

WATER WELL DRILLERS LOG

516 1974 J.T. Medlin Tippah
date well completed firm name county well located

LANDOWNER: James Medlin	description of formations encountered	from	to
Blue water			
RI	clay	0	15
(mailing address)	rock & clay	15	30
	blue "	30	78
	rock & sand	78	100

WELL LOCATION:
sec 32 T 5 N R 3 E
S W
1 miles N of Cotton Plant
(distance) (direction) (nearest town)

WELL PURPOSE:
(home, irrigation, municipal, industrial)

- WELL COMPLETION DATA:
- (1) diameter (inches) 4
 - (2) total depth (feet) 180
 - (3) static water level (feet) 2 below top of ground.
 - (4) casing P 40 (material) (depth)
 - (size) If telescope see back.
 - (5) screen O (length) (depth to top)
 - (size) (material)
 - (6) pump no (HP) (yield gpm)
 - (type power)
 - (7) electric log (yes or no)
 - (organization running log)
 - (8) how well bottom plugged


DRILLERS REMARKS:

CODED

RECEIVED
AUG 15 1974

If well telescopes please sketch and show depths.

GROUND LEVEL

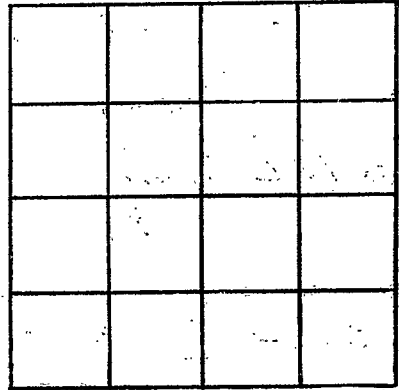

SECTION _____

Please indicate well location X.

ADDITIONAL INFORMATION

If more than one screen,
show locations of each on sketch.