

TIPPAN  
 N 44  
 11-6-74

MISSISSIPPI  
 BOARD OF WATER COMMISSIONERS  
 416 North State Street  
 Jackson, Mississippi 39201

WATER WELL DRILLERS LOG

CODED

Nov 6 1974 JT Miller Tippah  
 date well completed firm name county well located

LANDOWNER:  
 Babba Ford  
 Puleya Miss  
 (mailing address)

description of formations encountered	from	to
Clay	0	35
rock + clay	35	65
blue clay	65	76
rock + sand	96	120

WELL LOCATION:  
 sec. 5 T 5 N R 3 E  
 4 miles E of Blue Mt  
 (distance) (direction) (nearest town)

WELL PURPOSE:  
 (home, irrigation, municipal, industrial)

WELL COMPLETION DATA:

(1) diameter (inches) 4

(2) total depth (feet) 120

(3) static water level (feet) 35 below top of ground

(4) casing P 80 (material) (depth)

(size) If telescope see back.

(5) screen (length) (depth to top)

(size) (material)

(6) pump 1/2 8 (HP) (yield gpm)

E (type power)

(7) electric log (yes or no)

(organization running log)

(8) how well bottom plugged


CODED

RECEIVED  
 DEC 12 1974

DRILLERS REMARKS:

If well telescopes please sketch and show depths.

GROUND LEVEL

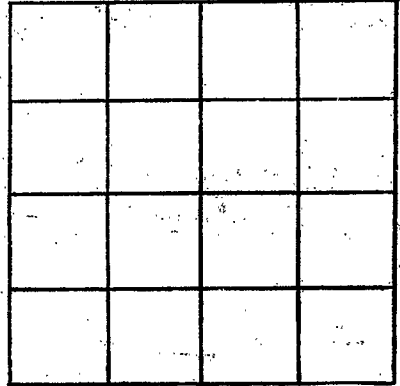

SECTION \_\_\_\_\_

Please indicate well location X.

ADDITIONAL INFORMATION

If more than one screen, show locations of each on sketch.