

TIPPAN
 N45
 8-24-79

MISSISSIPPI
 BOARD OF WATER COMMISSIONERS
 416 North State Street
 Jackson, Mississippi 39201

700.00
 100.00
 35.00
 735.00

WATER WELL DRILLERS LOG

8-24-1979 date well completed
 J.T. Medhi firm name
 Tippah county well located

LANDOWNER: Ozone
Medhi
Blue Mountain
 (mailing address)

description of formations encountered	from	to
W. Clay	0	19
Blue " "	19	20
rock & clay	20	160
blue " "	160	195
rock & sand	195	300

WELL LOCATION:
 sec. 18 T. S. N. R. 30 E
1 1/2 miles S of Shoemaker
 (distance) (direction) (nearest town)

CODED.

WELL PURPOSE:
 (home, irrigation, municipal, industrial)

WELL COMPLETION DATA:

(1) diameter (inches) 4

(2) total depth (feet) 300

(3) static water level (feet) 35 below above top of ground.

(4) casing P 65
 (material) (depth)
 (size) if telescope see back.

(5) screen _____
 (length) (depth to top)
 (size) (material)

(6) pump 1 7
 (HP) (yield gpm)
E
 (type power)

(7) electric log _____
 (yes or no)
 (organization running log)

(8) how well bottom plugged _____


MISSISSIPPI
 BOARD OF WATER COMMISSIONERS
 DEC 12 1979

MISS. BD. OF WATER COMMISSIONERS

DRILLERS REMARKS:

If well telescopes please sketch and show depths.

GROUND LEVEL

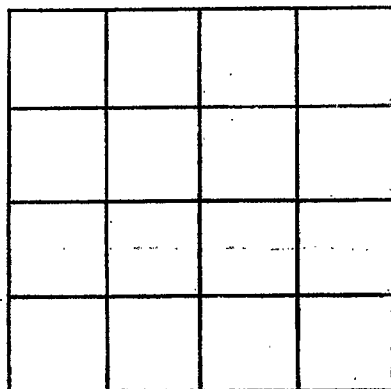

SECTION _____

Please indicate well location X.

ADDITIONAL INFORMATION

If more than one screen,
show locations of each on sketch.