

TIPPAH
N 46
3-18-75

MISSISSIPPI
BOARD OF WATER COMMISSIONERS
416 North State Street
Jackson, Mississippi 39201

WATER WELL DRILLERS LOG

CODED

3-18-75 1975 J. T. Medley Tippah
date well completed firm name county well located

LANDOWNER: Ronald W
Dumman
Proprietor
(mailing address)

description of formations encountered	from	to
Clay	0	13
Rock + Sand	13	48
Blocky Clay	48	127
Rock + Sand	127	265

WELL LOCATION:
sec. 11 T. 5 N. R. 3 E.
4 miles (distance) E (direction) of Phlox (nearest town)

WELL PURPOSE:
(home, irrigation, municipal, industrial)

WELL COMPLETION DATA:

(1) diameter (inches) 4

(2) total depth (feet) 260

(3) static water level (feet) 25 below above top of ground.

(4) casing P (material), 80 (depth)
if telescope see back.
(size)

(5) screen — (length), — (depth to top)
(size), (material)

(6) pump 1 (HP), 6 (yield gpm)
(type power)

(7) electric log — (yes or no)
(organization running log)

(8) how well bottom plugged 0

CODED


RECEIVED

APR 18 1975

DRILLERS REMARKS:

If well telescopes please sketch and show depths.

GROUND LEVEL

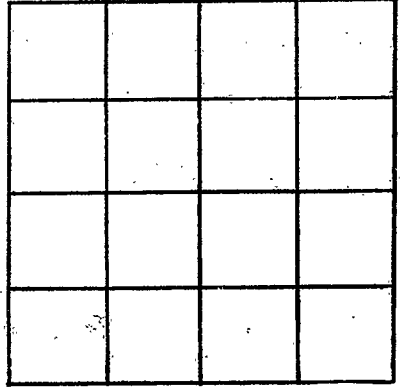

SECTION _____

Please indicate well location X.

ADDITIONAL INFORMATION

If more than one screen,
show locations of each on sketch.