

Lippah
N 50
7-8-75

MISSISSIPPI
BOARD OF WATER COMMISSIONERS
416 North State Street
Jackson, Mississippi 39201

WATER WELL DRILLERS LOG

CODED

7-8-75 date well completed J.T. Medlin firm name Lippah county well located

LANDOWNER: Stanley
CORN
Blue Mt. Miss
(mailing address)

description of formations encountered	from	to
<u>Clay</u>	<u>0</u>	<u>165</u>
<u>100% sand</u>	<u>165</u>	<u>365</u>

WELL LOCATION:
sec. 2 T. 5 N. R. 3 E. 15F
3 miles E of Blue Mt.
(distance) (direction) (nearest town)

CODED

WELL PURPOSE:
(home, irrigation, municipal, industrial)

WELL COMPLETION DATA:

(1) diameter (inches) 4

(2) total depth (feet) 265

(3) static water level (feet) 20 below above ground

(4) casing P 100
(material) (depth)
If telescope see back.
(size)

(5) screen _____
(length) (depth to top)
(size) (material)

(6) pump 2 6
(HP) (yield gpm)
C
(type power)

(7) electric log _____
(yes or no)
(organization running log)


(8) how well bottom plugged _____

DRILLERS REMARKS:

DECEMBER 1975
AUG 11 1975
MISSISSIPPI WATER COMMISSION

If well telescopes please sketch and show depths.

GROUND LEVEL

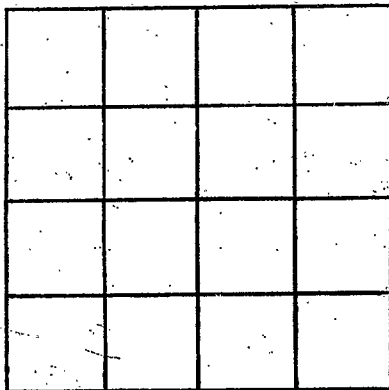

SECTION _____

Please indicate well location X.

ADDITIONAL INFORMATION

If more than one screen, show locations of each on sketch.