

Lippah  
MS  
4-15-75

MISSISSIPPI  
 BOARD OF WATER COMMISSIONERS  
 416 North State Street  
 Jackson, Mississippi 39201

WATER WELL DRILLERS LOG

4-15-75 date well completed      Bond Well Drilling firm name      Lippah county well located


LANDOWNER: <u>Ray Balogh</u>	description of formations encountered	from	to
<u>Blue Mountain</u> <u>Mississippi</u> (mailing address)			
	<u>Red clay</u>	<u>0</u>	<u>20</u>
	<u>Red sand</u>	<u>20</u>	<u>68</u>
	<u>Blue clay</u>	<u>68</u>	<u>355</u>
	<u>Water Sand</u>	<u>355</u>	<u>408</u>
<b>WELL LOCATION:</b> sec <u>7</u> T <u>S</u> N      R <u>3</u> <sup>15F</sup> <sub>(E)</sub> <sub>(W)</sub> <u>2 1/2</u> miles <u>W</u> of <u>Blue Mt.</u> (distance)      (direction)      (nearest town)			
<b>WELL PURPOSE:</b> <u>Home</u> (home, irrigation, municipal, industrial)			
<b>WELL COMPLETION DATA:</b>			
(1) diameter (inches) <u>4"</u>			
(2) total depth (feet) <u>408'</u>			
(3) static water level (feet) <u>110</u> <sup>below</sup> <sub>above</sub> top of ground.			
(4) casing <u>Steel</u> <u>78'6"</u> (material)      (depth)			
_____ (size) If telescope see back.			
(5) screen <u>None</u> (length)      (depth to top)			
_____ (size) _____ (material)			
(6) pump <u>3/4</u> <u>10</u> (HP)      (yield gpm)			
<u>Elect.</u> (type power)			
(7) electric log <u>NO</u> (yes or no)			
_____ (organization running log)			
(8) how well bottom plugged <u>Open</u>			
<b>DRILLERS REMARKS:</b> _____ _____ _____			

RECEIVED  
 MISSISSIPPI  
 SEP 24 1975

MISS. Bd. OF WATER COMMISSIONERS

If well telescopes please sketch and show depths.

GROUND LEVEL

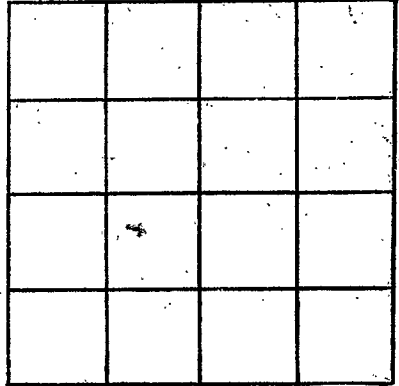

SECTION \_\_\_\_\_

Please indicate well location X.

ADDITIONAL INFORMATION

If more than one screen, show locations of each on sketch.