

TIPPAA
 N 52
 9-2-75

MISSISSIPPI
 BOARD OF WATER COMMISSIONERS
 416 North State Street
 Jackson, Mississippi 39201

WATER WELL DRILLERS LOG


Sept. 2, 1975 ^{15F} ~~Hee~~ Tippah
 date well completed firm name county well located
 J.T. [unclear]

LANDOWNER:	description of formations encountered	from	to
JOE WHITE			
New Hope Community (mailing address)			
WELL LOCATION: sec. <u>25</u> T. <u>5</u> N. R. <u>30</u> E. <u>6</u> miles (distance) S. (direction) of <u>Tippah</u> (nearest town)			
WELL PURPOSE: (home, irrigation, municipal, industrial)			
WELL COMPLETION DATA: (1) diameter (inches) <u>4</u> (2) total depth (feet) <u>0</u> (3) static water level (feet) <u>60</u> below/above top of ground. (4) casing <u>P</u> (material) <u>25'</u> (depth) if telescope see back. (5) screen <u>10</u> (length) <u>65</u> (depth to top) <u>4</u> (size) (material) (6) pump <u>3</u> (HP) <u>8</u> (yield gpm) <u>3</u> (type power) (7) electric log _____ (yes or no) (organization running log) (8) how well bottom plugged _____	SAND & ROCK	20	0
DRILLERS REMARKS:	3rd East of Blue Mt. - NEW HOPE COMMUNITY		

RECEIVED
 OCT 16 1975

If well telescopes please sketch and show depths.

GROUND LEVEL

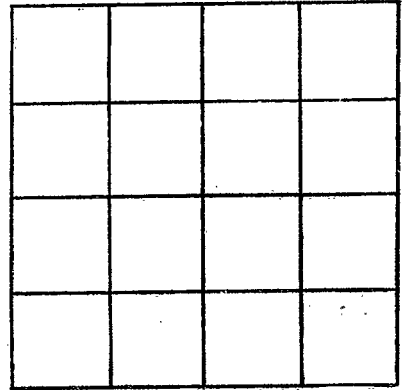

SECTION _____

Please indicate well location X.

ADDITIONAL INFORMATION

If more than one screen, show locations of each on sketch.