

**MISSISSIPPI
BOARD OF WATER COMMISSIONERS
416 North State Street
Jackson, Mississippi 39201**

CODED

WATER WELL DRILLERS LOG

Tippah*
J70 N55
6/1/79
Elwg #24

June 19 79 Herndon Well & Supply, Inc. Tippah
 date well completed firm name county well located

LANDOWNER: Town of Blue Mountain, Blue Mountain, MS (mailing address)	description of formations encountered	from	to
	Red Sand	0	7
	White Chalk	7	15
	Coarse White Sand	15	22
	Rock	22	23
	Coarse Yellow Sand	23	25
	Shale Rock	25	30
	Coarse White Sand	30	150
	Blue Clay	150	275
	Sandy Blue Clay	275	315
	Sand	315	330
	Rock	330	331
	Sand	331	333
	Rock	333	334
	Sand & Shale Rock	334	376
	Rock	376	377
	Sand	377	395
	Rock	395	396
	Sandy Blue Clay	396	417
	Rock	417	418
	Blue Clay, Shale Rock	418	463
	Rock	463	464
	Blue Clay	464	470
	Rock	470	471
	Blue Clay	471	500
	Rock	500	501
	Blue Sand	501	535
	Rock	535	536
	Sandy Blue Clay	536	555
	Rock	555	556
	Blue Clay, Sand Streaks	556	1020
	Rock	1020	1021
	Sand	1021	1060
	Sandy Blue Clay	1060	1090
	Sand Clay Streaks	1090	1190
	Rock	1190	1191
	Sandy Blue Clay	1191	1240

CODED

WELL LOCATION:
 sec. 6 T 4 N R 3 E
 5 S W
 Inside City Limits
 (distance) miles (direction) of (nearest town)

WELL PURPOSE: Municipal
 (home, irrigation, municipal, industrial)

WELL COMPLETION DATA:

(1) diameter (inches) 10 x 6"

(2) total depth (feet) 1185'

(3) static water level (feet) 325' below top of ground.

(4) casing Steel 1060'
 (material) (depth)
 10" if telescope see back.
 (size)

(5) screen 48'9" 1060'
 (length) (depth to top)
 6" Stainless Steel
 (size) (material)

(6) pump 75 254
 (HP) (yield gpm)
 electric
 (type power)

(7) electric log yes
 (yes or no)
 U S Geo. Survey
 (organization running log)

(8) how well bottom plugged 6" BWV
 Miss. Board of Water Comm.

DRILLERS REMARKS:


JUN 14 1979

RECEIVED

(X)

If well telescopes please sketch and show depths.

GROUND LEVEL

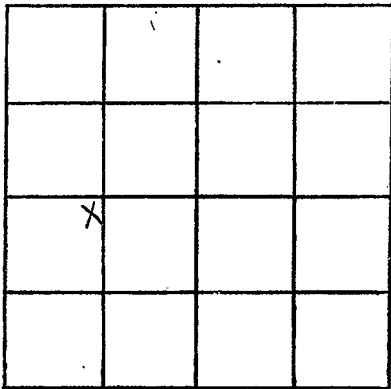

SECTION _____

Please indicate well location X.

ADDITIONAL INFORMATION

325' S.W.L.

1060' of 10" Casings

Top of LAP 979

$$\begin{array}{r}
 979 \\
 81 \\
 \hline
 1050 \\
 40
 \end{array}$$

80' 8"-6" LAP

40' of 6" Screen

12yds 10-30
Gravel

.025 slot

40' 10 1/2" Blank

44' 9" 6" Screen

TP 1185

6" BW

If more than one screen, show locations of each on sketch.

6-11