

MISSISSIPPI DEPARTMENT OF ENVIRONMENTAL QUALITY

Office of Land and Water Resources

P. O. Box 10631
Jackson, MS 39289-0631
WATER WELL DRILLERS LOG

COUNTY WELL LOCATED TIPPAH	
WELL NUMBER N-57	CODED
DATE WELL COMPLETED 5-1-02	

PERMIT NUMBER
NAME OF DRILLING FIRM MEDLIN

NAME & MAILING ADDRESS OF LANDOWNER COOMBS, REALTY		
WELL SITE 1 mile S.W. Blue Mt		
Latitude:	CE 827	
Longitude:		
WELL LOCATION	SEC 7	TOWNSHIP S 5
		RANGE 3
DISTANCE 3/4 Miles	DIRECTION S.W.	NEAREST TOWN Blue Mt
OTHER LANDMARK R.R. TRACK		
WELL PURPOSE (Home Irrigation, Municipal, Industrial, Fish Pond, etc.)		

PUMP DATA		
PUMP TYPE (Circle One): <input checked="" type="checkbox"/> Submersible Turbine Jet Flowing Well, Other (Describe) _____		
POWER TYPE (Circle One): <input checked="" type="checkbox"/> Electric Tractor Diesel Gasoline Butane, Other (Describe) _____ H/P 1/2		
DESCRIPTION OF FORMATIONS ENCOUNTERED	FROM	TO
Sand Rock		
& top soil	0	40
Mix Rock		
Blue Clay	40	160
Rock (shell)		
Sand		
Aquifer	160	280
RECEIVED		
FEB 07 2003		
BY: OLWR		
Top of Lap Pipe or Reduction in Casing		
FEET	IF TELESCOPED OR MORE THAN ONE SCREEN: USE BACK PAGE	

WELL DATA		
Well Depth 280	Casing Diameter (In.) 4"	Casing Length (Ft.) 160'
Type of Casing PVC	Hole Depth 280	Depth to Static Water Level 60'
TYPE OF COMPLETION: (Circle One or More): Gravel Packed, Underreamed, Telescoped, Natural Development, <input checked="" type="checkbox"/> Open Hole, Other		
WELL GROUTED TO A DEPTH OF 10 FEET Type Grout (circle one): <input checked="" type="checkbox"/> Cement, <input checked="" type="checkbox"/> Bentonite, or <input checked="" type="checkbox"/> Mix		

SCREEN DATA		
Diameter - Inches No	Length - Feet Screen	Slot Size - Inches
Screen Type	Depth to Bottom - Feet ENK	


I certify that the well was drilled, constructed and completed in accordance with all applicable Requirements of the Mississippi Department of Environmental Quality and/or the Mississippi Department of Health regulations and state laws.

James R Medlin 0429 today **2-4-03**
Signature of Licensed Driller and License No. Date

Additional Information Required On Back

If well telescopes please sketch and show depths.

GROUND LEVEL

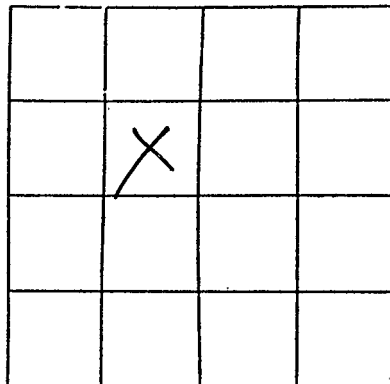

SECTION 18

Please indicate well location X.

Pump Capacity (GPM)	No. of Stages	Setting Depth	
<u>10</u>	<u>9</u>	<u>100</u>	FT.

PUMP TEST

Well yielded 10 GPM with
 a drawdown of 6 ft.
 after 8 hours of pumping

LOG DATA

TYPE OF LOG RUN (Circle One): No Log Run,
 Electric, Gamma Ray, Density, Sonic, Neutron,
 Other (Describe) _____

Name of Organization Running Log _____

GEOLOGIC DATA (Office Use Only)

Surface Elev.	Geologic Unit	Unit Thickness	Depth to Top
Subs. SWL	Date	Analysis	Aquifer Test

Driller's Remarks

If more than one screen,
 show location of each on sketch.