

Tippah
 N 2000
 10-23-75

MISSISSIPPI
 BOARD OF WATER COMMISSIONERS
 416 North State Street
 Jackson, Mississippi 39201

WATER WELL DRILLERS LOG


Oct 23, 1975 J.T. Medlin Tippah
 date well completed firm name county well located

LANDOWNER:	description of formations encountered	from	to
Snoody Bryant R#1 Blue Mt N MS. (mailing address)			
WELL LOCATION: sec. <u>T5 N R3 E</u> S. <u>S-E</u> of <u>Blue Mt N</u> (distance) (direction) (nearest town)	SAND + ROCK CLAY	15	75
WELL PURPOSE: <u>home</u> (home, irrigation, municipal, industrial)	SAND + ROCKS	110	170
WELL COMPLETION DATA: (1) diameter (inches) <u>4 in.</u> (2) total depth (feet) <u>170</u> (3) static water level (feet) <u>40</u> below above top of ground. (4) casing <u>PL.</u> <u>90</u> (material) (depth) <u> </u> if telescope see back. (size) (5) screen <u> </u> <u> </u> (length) (depth to top) <u> </u> (size) <u> </u> (material) (6) pump <u>1/2</u> <u>7</u> (HP) (yield gpm) <u>Elec</u> (type power) (7) electric log <u> </u> (yes or no) <u> </u> (organization running log) (8) how well bottom plugged <u>C</u>			
DRILLERS REMARKS:			

RECEIVED
 DEC - 8 1975

If well telescopes please sketch and show depths.

GROUND LEVEL

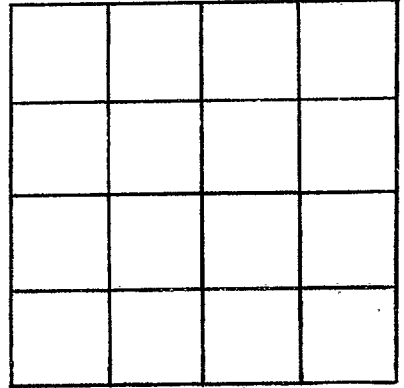

SECTION _____

Please indicate well location X.

ADDITIONAL INFORMATION

If more than one screen, show locations of each on sketch.