

MISSISSIPPI  
BOARD OF WATER COMMISSIONERS  
416 North State Street  
Jackson, Mississippi 39201

WATER WELL DRILLERS LOG

Jiprah  
N 2001  
11/2/75

Nov 2 1975 JT Medlin Jiprah  
date well completed firm name county well located

LANDOWNER:  
S.V. Heugly  
Blue Mt MS. 38610  
(mailing address)

description of formations encountered	from	to
<u>CLAY</u>	<u>0</u>	<u>30</u>
<u>ROCKS &amp; CLAY</u>	<u>30</u>	<u>80</u>
<u>CLAY</u>	<u>80</u>	<u>120</u>
<u>SAND ROCKS</u>	<u>120</u>	<u>200</u>

WELL LOCATION:  
sec 365 T 5 N R30 15F  
3 miles E of Blue Mt  
(distance) (direction) (nearest town)

WELL PURPOSE:  
 (home) irrigation, municipal, industrial


- WELL COMPLETION DATA:
- diameter (inches) 4
  - total depth (feet) 200
  - static water level (feet) 50 below top of ground.
  - casing PL 90  
(material) (depth)  
         if telescope see back.  
(size)
  - screen                    
(length) (depth to top)  
         (size) (material)
  - pump 1/2 8  
(HP) (yield gpm)  
Elec.  
(type power)
  - electric log           
(yes or no)  
          
(organization running log)
  - how well bottom plugged

DRILLERS REMARKS:  
          
          
        

RECEIVED  
DEC - 6 1975

If well telescopes please  
sketch and show depths.

GROUND LEVEL

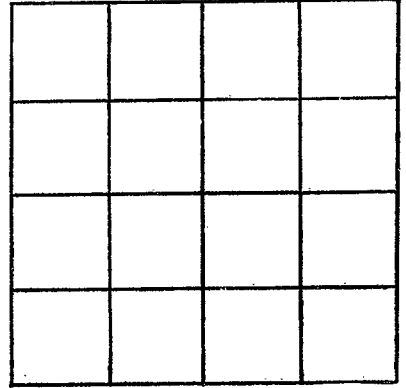

SECTION \_\_\_\_\_

Please indicate well location X.

ADDITIONAL INFORMATION

If more than one screen,  
show locations of each on sketch.