

MISSISSIPPI
BOARD OF WATER COMMISSIONERS
416 North State Street
Jackson, Mississippi 39201

WATER WELL DRILLERS LOG

Tippah
N 2002
11/25/75

Nov 25 19 *75* *JT Medlin* *Tippah*
date well completed firm name county well located

LANDOWNER: <i>E.A. JOHNSON</i>	description of formations encountered	from	to
<i>COTTON PLANT MS.</i> (mailing address)			
WELL LOCATION: <i>sec 30 S 15 F to 30 N</i> <i>3</i> miles <i>N.W.</i> of <i>COTTON PLANT</i>	<i>Clay</i>	<i>0</i>	<i>80</i>
	<i>Sand & Rock</i>	<i>80</i>	<i>140</i>
	<i>Clay</i>	<i>140</i>	<i>250</i>
	<i>sand & Rock</i>	<i>250</i>	<i>300</i>

WELL PURPOSE:
(home, irrigation, municipal, industrial)

WELL COMPLETION DATA:

(1) diameter (inches) *4 in*

(2) total depth (feet) *300 ft*

(3) static water level (feet) *90* below above top of ground.

(4) casing *Pl*, *160*
(material) (depth)

_____ if telescope see back.
(size)

(5) screen _____
(length) (depth to top)

_____ (size) _____ (material)

(6) pump *1/2* *7*
(HP) (yield gpm)

gla
(type power)

(7) electric log _____
(yes or no)

_____ (organization running log)


(8) how well bottom plugged _____

REGISTERED
DEC - 8 1975

DRILLERS REMARKS:

If well telescopes please
sketch and show depths.

GROUND LEVEL

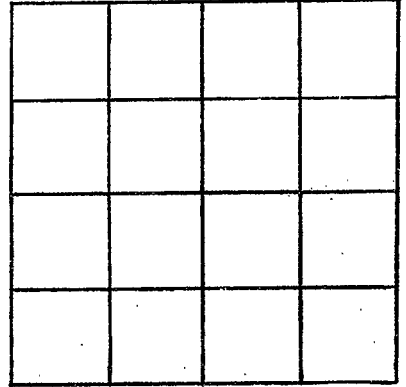

SECTION _____

Please indicate well location X.

ADDITIONAL INFORMATION

If more than one screen,
show locations of each on sketch.