

Tippan
 N 2003
 1-7-76

MISSISSIPPI
 BOARD OF WATER COMMISSIONERS
 416 North State Street
 Jackson, Mississippi 39201

15F

WATER WELL DRILLERS LOG


1-7-1976 date well completed
 W. J. Mallin firm name
 Tippan county well located

LANDOWNER:	description of formations encountered	from	to
S. V. Hargraves Rt 2 Blue mtn. (mailing address)			
WELL LOCATION: sec. 10 T ^S N R ³ E 3 mi S miles East of Blue mtn. (distance) (direction) (nearest town)	Mud + sand sand, gravel	130-210 210-220	
WELL PURPOSE: (home, irrigation, municipal, industrial)			
WELL COMPLETION DATA: (1) diameter (inches) 4 in (2) total depth (feet) 260 ft (3) static water level (feet) 200 below top of ground. (4) casing (material) Plastic (depth) 210 (size) if telescope see back. (5) screen (length) (depth to top) (size) (material) (6) pump (HP) 2-4 (yield gpm) (type power) (7) electric log (yes or no) (organization running log) (8) how well bottom plugged			
DRILLERS REMARKS:			

RECEIVED
 FEB 2 - 1976

If well telescopes please sketch and show depths.

GROUND LEVEL

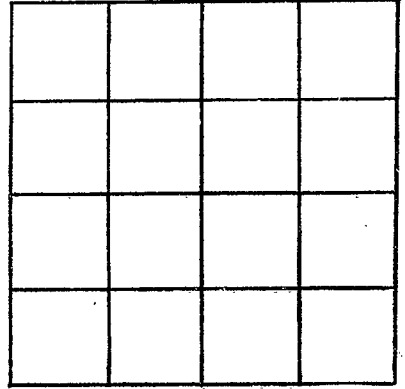

SECTION _____

Please indicate well location X.

ADDITIONAL INFORMATION

If more than one screen,
show locations of each on sketch.