

Tippah
 N 2005
 9-14-76

MISSISSIPPI
 BOARD OF WATER COMMISSIONERS
 416 North State Street
 15F Jackson, Mississippi 39201

WATER WELL DRILLERS LOG

9/14/76 date well completed
 MEDLIN WELLD RILLING firm name
 TIPPAAH county well located

LANDOWNER: ARTIE RELAFORD
 BLUE Mtn. Miss
 (mailing address)

description of formations encountered	from	to
Clay	0	50
Blue Mud	50	190
Sand and Rack	190	240

WELL LOCATION:
 sec. T 5 N R 3 E
 3 miles SOUTH of BLUE Mtn.
 (distance) (direction) (nearest town)

WELL PURPOSE: HOME
 (home, irrigation, municipal, industrial)

- WELL COMPLETION DATA:
- (1) diameter (inches) 4
 - (2) total depth (feet) 240
 - (3) static water level (feet) 75 below above top of ground
 - (4) casing PLASTIC 120 (material) (depth)
 (size) If telescope see back.
 - (5) screen (length) (depth to top)
 (size) (material)
 - (6) pump LAPJET 7 (HP) (yield gpm)
 (type power)
 - (7) electric log (yes or no)
 (organization running log)
 - (8) how well bottom plugged

RECEIVED


DEC 2 1976

DRILLERS REMARKS:

MISS. BD. OF WATER COMM

If well telescopes please sketch and show depths.

GROUND LEVEL

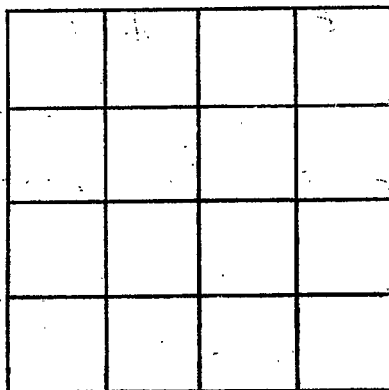

SECTION _____

Please indicate well location X.

ADDITIONAL INFORMATION

If more than one screen, show locations of each on sketch.