

TIPPDAH
N 2008

MISSISSIPPI
BOARD OF WATER COMMISSIONERS
416 North State Street
Jackson, Mississippi 39201

WATER WELL DRILLERS LOG

5-28-78 date well completed
Byzant Well Drilling firm name
Tippah county well located

LANDOWNER:	description of formations encountered	from	to
Mattie Shuckland Blue Mtn. Miss (mailing address)			

WELL LOCATION:
sec. 3 T 5 N R 3 E
5 miles South of Blue Mtn.
(distance) (direction) (nearest town)

WELL PURPOSE: Home
(home, irrigation, municipal, industrial)

- WELL COMPLETION DATA:
- (1) diameter (inches) 4"
 - (2) total depth (feet) 200
 - (3) static water level (feet) 60 ^{below} top of ground.
 - (4) casing Pvc 115
(material) (depth)
 - (size) if telescope see back.
 - (5) screen (length) (depth to top)
 - (size) (material)
 - (6) pump 9
(HP) (yield gpm)
 - Elco
(type power)
 - (7) electric log (yes or no)
 - (organization running log)
 - (8) how well bottom plugged Open


DRILLERS REMARKS:

RECEIVED

AUG - 3 1978

If well telescopes please
sketch and show depths.

GROUND LEVEL

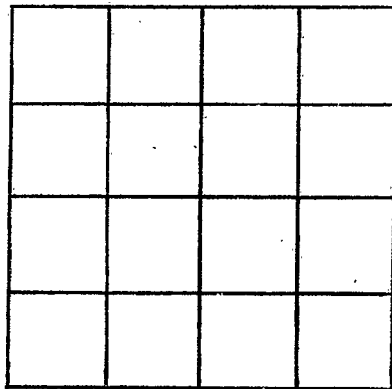

SECTION _____

Please indicate well location X.

ADDITIONAL INFORMATION

If more than one screen,
show locations of each on sketch.