

TIPPAH
N 2009

MISSISSIPPI
BOARD OF WATER COMMISSIONERS
416 North State Street
Jackson, Mississippi 39201

WATER WELL DRILLERS LOG

4-23-78 19 Bryant Well Drilling Tippah
date well completed firm name county well located

LANDOWNER:
James R. Medlin
Blue Mtn Miss
(mailing address)

description of formations encountered	from	to
Mixed Clay	0	40
Clay & Sand	40	60
Blue Clay	60	210
Sand & Gravel	210	275

WELL LOCATION:
sec. 3 T 5 N R 3 E
4 1/2 miles South of Blue Mtn
(distance) (direction) (nearest town)

WELL PURPOSE: Home
(home, irrigation, municipal, industrial)

WELL COMPLETION DATA:

(1) diameter (inches) 4"

(2) total depth (feet) 275

(3) static water level (feet) 85 below top of ground.

(4) casing Plas 130
(material) (depth)

(size) If telescope see back.

(5) screen (length) (depth to top)

(size) (material)

(6) pump 1/2 10
(HP) (yield gpm)

Elec
(type power)

(7) electric log (yes or no)

(organization running log)

(8) how well bottom plugged Open


DRILLERS REMARKS:

RECEIVED
AUG - 3 1978

MISS. BD. OF WATER COM.

If well telescopes please sketch and show depths.

GROUND LEVEL

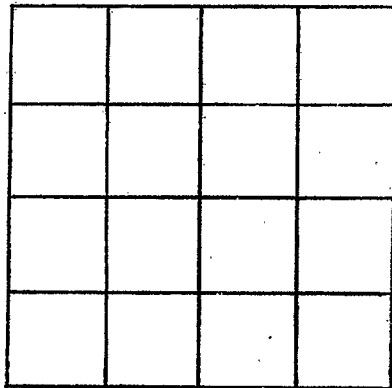

SECTION _____

Please indicate well location X.

ADDITIONAL INFORMATION

If more than one screen,
show locations of each on sketch.