

TIPPAH
N 2010

MISSISSIPPI
BOARD OF WATER COMMISSIONERS
416 North State Street
Jackson, Mississippi 39201

WATER WELL DRILLERS LOG

4-29-78 19 Bryants Well Drilling Tippah
date well completed firm name county well located

LANDOWNER:	description of formations encountered	from	to
(mailing address)			
<u>Pasfel Tugan</u>	<u>Mixed Clay</u>	<u>0</u>	<u>40</u>
<u>Blue Mtn.</u>	<u>Clay & Rocks</u>	<u>40</u>	<u>100</u>
	<u>Sand & Rock</u>	<u>100</u>	<u>160</u>


WELL LOCATION:
sec. 3 T. 5 N. R. 3 E
0 miles East of Blue Mtn.
(distance) (direction) (nearest town)

WELL PURPOSE: Home
(home, irrigation, municipal, industrial)

- WELL COMPLETION DATA:
- (1) diameter (inches) 4
 - (2) total depth (feet) 160
 - (3) static water level (feet) 80 ^{below} _{above} top of ground.
 - (4) casing Plas, 160,
(material) (depth)
(size) if telescope see back.
 - (5) screen 10, 150
(length) (depth to top)
4", Plas
(size) (material)
 - (6) pump 1/2, 10
(HP) (yield gpm)
Elec
(type power)
 - (7) electric log
(yes or no)

(organization running log)
(8) how well bottom plugged Plas Caps


DRILLERS REMARKS:

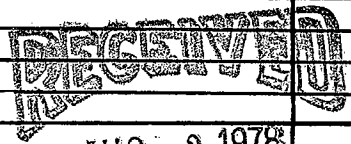

AUG - 3 1978

If well telescopes please sketch and show depths.

GROUND LEVEL

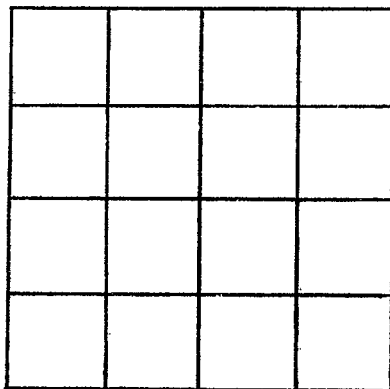

SECTION _____

Please indicate well location X.

ADDITIONAL INFORMATION

If more than one screen, show locations of each on sketch.