

TIPPAH

N 2011

12-1-78

MISSISSIPPI BOARD OF WATER COMMISSIONERS
416 North State Street
Jackson, Mississippi 39201

WATER WELL DRILLERS LOG

12-1 1978 Bonds Well Drilling firm name Tippah county well located

LANDOWNER: Jimmy Lawson

Dumas

(mailing address)

WELL LOCATION:

sec 23 T-5 N R-3 E

3 1/2 miles W of Dumas
(distance) (direction) (nearest town)

WELL PURPOSE: Home
(home, irrigation, municipal, industrial)

WELL COMPLETION DATA:

- (1) diameter (inches) 4"
- (2) total depth (feet) 195'
- (3) static water level (feet) 80' ^{below} top of ground
- (4) casing Plastic / 110
(material) (depth)
(size) If telescope see back.
- (5) screen no
(length) (depth to top)
(size) (material)
- (6) pump 3/4 / 10 gpm
(HP) (yield gpm)
electric
(type power)
- (7) electric log no
(yes or no)
(organization running log)
- (8) how well bottom plugged open

description of formations encountered

from to

Red Clay	0	20
yellow sand	20	100
Blue Clay	100	130
Water Sand	130	195


DRILLERS REMARKS:

RECEIVED
DEC - 5 1978

MISS. BD. OF WATER COMMISSIONERS

If well telescopes please sketch and show depths.

GROUND LEVEL

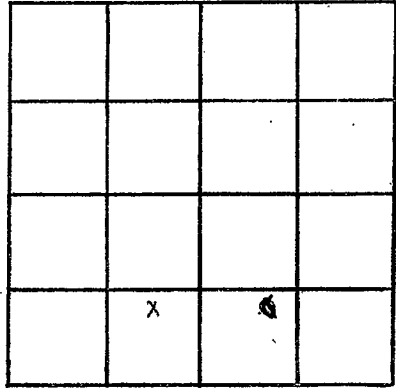

SECTION _____

Please indicate well location X.

ADDITIONAL INFORMATION

If more than one screen,
show locations of each on sketch.