

TIPPAH

N 2012

5/18/79

MISSISSIPPI BOARD OF WATER COMMISSIONERS
416 North State Street
Jackson, Mississippi 39201

WATER WELL DRILLERS LOG

5-18-79
date well completed

J T Medina
firm name

Tipphah
county well located

LANDOWNER: J.E. Harrington
Blue Mtn, MS

description of formations encountered	from to	
Clay	0	125
Rock & sand	125	230

(mailing address)

WELL LOCATION:

sec. 31 T 5 N R 3 E
S W
2 miles N.W. of Blue mtn
(distance) (direction) (nearest town)

WELL PURPOSE:

(home, irrigation, municipal, industrial)

WELL COMPLETION DATA:

- (1) diameter (inches) 4
- (2) total depth (feet) 250
- (3) static water level (feet) 18 below top of ground.
- (4) casing P 75 (material) (depth)
- (size) If telescope see back.
- (5) screen 10 260 (length) (depth to top)
- (size) (material)
- (6) pump 5 14 (HP) (yield gpm)
- (type power) E
- (7) electric log (yes or no)

(organization running log)

(8) how well bottom plugged spec

Miss. Board of Water Comm.


AUG 16 1979

DRILLERS REMARKS:

RECEIVED

If well telescopes please sketch and show depths.

GROUND LEVEL

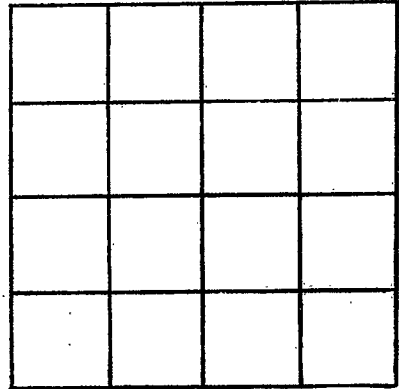

SECTION _____

Please indicate well location X.

ADDITIONAL INFORMATION

If more than one screen, show locations of each on sketch.