

TIPPAH

N 2013

7/08/79

MISSISSIPPI  
 BOARD OF WATER COMMISSIONERS  
 416 North State Street  
 Jackson, Mississippi 39201

7

WATER WELL DRILLERS LOG

7-8-79

date well completed

J. T. Medina

firm name

Tipphah

county well located

LANDOWNER: Danna

Boyant

Blue mtn 713  
(mailing address)

description of formations encountered

Clay  
Sand  
Rock & Clay  
" & Sand

from to

0 10  
10 40  
40 120  
120 180

WELL LOCATION:

sec. 9 T. 5 N. R. 3 E.

3 miles E of Blue Mtn  
(distance) (direction) (nearest town)

WELL PURPOSE:

(home, irrigation, municipal, industrial)

WELL COMPLETION DATA:

- (1) diameter (inches) 4
- (2) total depth (feet) 180
- (3) static water level (feet) 30 below top of ground.
- (4) casing P 80  
(material) (depth)  
- (size) if telescope see back.
- (5) screen 10  
(length) (depth to top)  
(size) (material)
- (6) pump 1/2 12  
(HP) (yield gpm)  
E  
(type power)
- (7) electric log (yes or no)

(organization running log)

(8) how well bottom plugged gr

DRILLERS REMARKS:


Miss. Board of Water Comm.

AUG 16 1979

RECEIVED

If well telescopes please sketch and show depths.

GROUND LEVEL

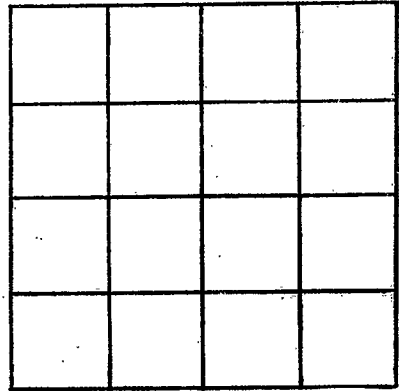

SECTION \_\_\_\_\_

Please indicate well location X.

ADDITIONAL INFORMATION

If more than one screen, show locations of each on sketch.