

Jippek
N
2015

MISSISSIPPI DEPARTMENT OF NATURAL RESOURCES
Bureau of Land and Water Resources
Southport Mall
P.O. Box 10631
Jackson, Mississippi 39209
WATER WELL DRILLERS LOG

9.7 1984 Medlin Jippek
date well completed firm name county well located

LANDOWNER:
Mike Wornington
Blue Mountain
(mailing address)

description of formations encountered	from	to
<u>Rock + Top Soil</u>	<u>0</u>	<u>90</u>

WELL LOCATION:
sec 32 T 5 R 3 E
1 miles West of Cottonport
(distance) (direction) (nearest town)

<u>Aquifer + clay</u>	<u>90</u>	<u>150</u>
-----------------------	-----------	------------

WELL PURPOSE:
(home) irrigation, municipal, industrial

WELL COMPLETION DATA:

(1) diameter (inches) 4"

(2) total depth (feet) 120

(3) static water level (feet) 60 below above top of ground.

(4) casing PVC 120'
(material) (depth)
_____ if telescope see back.
(size)

(5) screen 10' 110'
(length) (depth to top)
4" PVC
(size) (material)

(6) pump 1 10
(HP) (yield gpm)
Elec.
(type power)

(7) electric log _____
(yes or no)

_____ (organization running log)

(8) how well bottom plugged _____

DRILLERS REMARKS:


DEPT. OF NATURAL RESOURCES
BUREAU OF LAND & WATER RESOURCES

SEP 17 1984

RECEIVED

If well telescopes please
sketch and show depths.

GROUND LEVEL

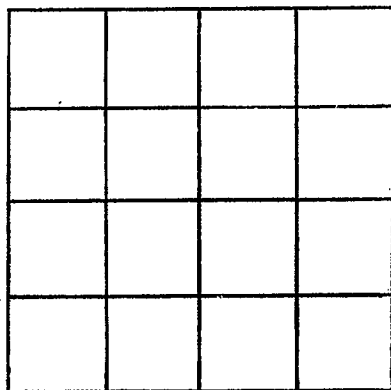

SECTION _____

Please indicate well location X.

ADDITIONAL INFORMATION

If more than one screen,
show locations of each on sketch.