

MISSISSIPPI DEPARTMENT OF NATURAL RESOURCES

Bureau of Land and Water Resources

Southport Mall

P.O. Box 10631

Jackson, Mississippi 39209

WATER WELL DRILLERS LOG

Tippah
N 2016

5.25.85
date well completed

Medlin Water Well
firm name

Tippah
county well located

LANDOWNER:	description of formations encountered	from	to
Jerry Rutherford Blue Mountain, MS. (mailing address)	Top soil & Limestone	0	80
	Red sand & Limestone	80	130
	Rock & Limestone	130	275
	Aquifer	275	380

WELL LOCATION:
sec. 3 T. 5 N. R. 3 E. S. W.
3 miles South of B.M.
(distance) (direction) (nearest town)

WELL PURPOSE:
(home, irrigation, municipal, industrial)

WELL COMPLETION DATA:

(1) diameter (inches) 4"

(2) total depth (feet) 380'

(3) static water level (feet) 120' below above top of ground.

(4) casing PVC 210' (material) (depth)
(size) if telescope see back.

(5) screen (length) (depth to top)
(size) (material)

(6) pump 1/2 (HP) 8 (yield gpm)
Electric (type power)

(7) electric log (yes or no)
(organization running log)

(8) how well bottom plugged


RECEIVED
MAR 8 - 1986

DRILLERS REMARKS:

Department of Natural Resources
Bureau of Land & Water Resources

If well telescopes please sketch and show depths.

GROUND LEVEL

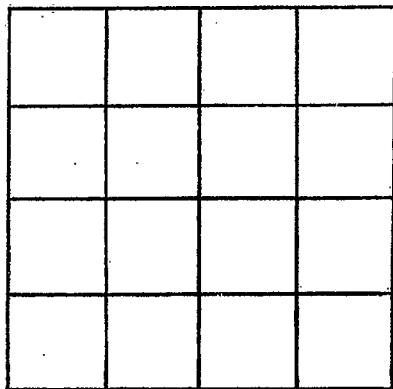

SECTION _____

Please indicate well location X.

ADDITIONAL INFORMATION

If more than one screen,
show locations of each on sketch.