

MISSISSIPPI DEPARTMENT OF ENVIRONMENTAL QUALITY

Office of Land and Water Resources

P. O. Box 10631
Jackson, MS 39289-0631
WATER WELL DRILLERS LOG

COUNTY WELL ID AREA Tipton		
WELL NUMBER 2 N	CODED 2019	PERMIT NUMBER
DATE WELL COMPLETED 3-8-98		NAME OF DRILLING FIRM Mudh

NAME & MAILING ADDRESS OF LANDOWNER
**Chris Coombs
Blue Mtn MS**

WELL LOCATION: SEC **33** TOWNSHIP **5 N** RANGE **3 E**

DISTANCE **1** Miles DIRECTION **N** NEAREST TOWN **Cotton Plant**

OTHER LANDMARKS
Old Rainey Place

WELL PURPOSE: Home, Irrigation, Municipal, Industrial, Fish Pond, etc.

PUMP DATA

PUMP TYPE (Circle One):
 Submersible, Turbine, Jet, Flowing Well,
Other (Describe) _____

POWER TYPE (Circle One):
 Electric, Tractor, Diesel, Gasoline, Butane,
Other (Describe) _____ H/P **1**

Pump Capacity (GPM) **18** No. of Stages _____ Setting Depth **200'** FT.

PUMP TEST
Well yielded **18** GPM with a drawdown of **12** ft. after **12** hours of pumping

WELL DATA

Well Depth 380	Casing Diameter (In.) 4"	Casing Length (Ft.) 360
Type of Casing PVC	Hole Depth 380	Depth to Static Water Level 60'

TYPE OF COMPLETION: (Circle One or More):
 Gravel Packed, Underreamed, Telescoped,
 Natural Development, Open Hole, Other
(Describe) _____

WELL GROUTED TO A DEPTH OF **20** FEET
Type Grout (circle one): Cement, Bentonite, or Mix

LOG DATA

TYPE OF LOG RUN (Circle One): No Log Run, Electric, Gamma Ray, Density, Sonic, Neutron, Other (Describe) _____

Name of Organization Running Log _____

SCREEN DATA

Diameter - Inches 4	Length - Feet 20	Slot Size - Inches 013
Screen Type PVC	Depth to Bottom - Feet 360-380	

GEOLOGIC DATA (Office Use Only)

Surface Elev.	Geologic Unit	Unit Thickness	Depth to Top
Subs. SWL	Date	Analysis	Aquifer Test

Driller's Remarks _____

Top of Lap Pipe or Reduction in Casing _____

FEET IF TELESCOPED OR MORE THAN ONE SCREEN: USE BACK PAGE

DESCRIPTION OF FORMATIONS ENCOUNTERED	FROM	TO
Top Soil	0	120
Rock Clay Mix		
Shale rock mix	120	260
Sand Clay		
Argillite rock	260	380

FORMATIONS (Continued)

RECEIVED


MAY 28 1999

Dept of Environmental Quality
Office of Land & Water Resources

IF MORE SPACE IS NEEDED, USE BACK

If well telescopes please sketch and show depths.

GROUND LEVEL

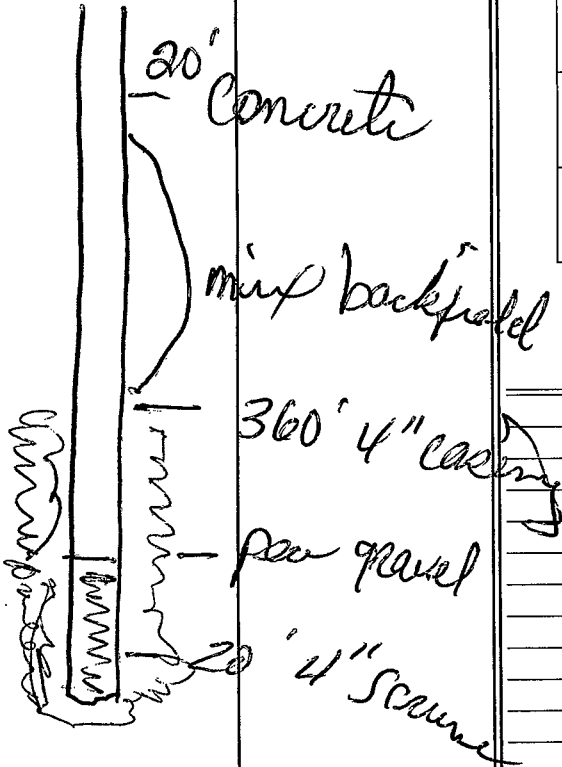

SECTION

33

Please indicate well location X.

ADDITIONAL INFORMATION

If more than one screen, show location of each on sketch.

33