

Zippah
07
4-20-67

MISSISSIPPI
 BOARD OF WATER COMMISSIONERS
 416 North State Street
 Jackson, Mississippi 39201

CODED

WATER WELL DRILLERS LOG

4-20-1967 date well completed Jennell Well Co. firm name Zippah county well located

LANDOWNER: Wilson Fryar
Blue Mtn Miss.
 (mailing address)

description of formations encountered	from	to
	<u>Mixt Soil + Clay</u>	<u>0</u>
<u>Soil + Rock</u>	<u>100</u>	<u>180</u>

WELL LOCATION:
 sec. 18 T. 5 S. R. 4 E
4 miles E of Blue Mtn
 (distance) (direction) (nearest town)

WELL PURPOSE: Home
 (home, irrigation, municipal, industrial)

CODED

WELL COMPLETION DATA:

(1) diameter (inches) 4

(2) total depth (feet) 180

(3) static water level (feet) 90 below top of ground.

(4) casing PVC, 180
 (material) (depth)
4 if telescope see back.
 (size)

(5) screen 20, 180
 (length) (depth to top)
1/32, galv
 (size) (material)

(6) pump 3/4, 6
 (HP) (yield gpm)
Elec
 (type power)

(7) electric log NO
 (yes or no)
0
 (organization running log)

(8) how well bottom plugged PVC
4

DRILLERS REMARKS:

DEC 10 1968

MISS. BD. OF
 WATER COMM.

If well telescopes please sketch and show depths.


GROUND LEVEL

4"

160 ft

20

Screen
180 ft

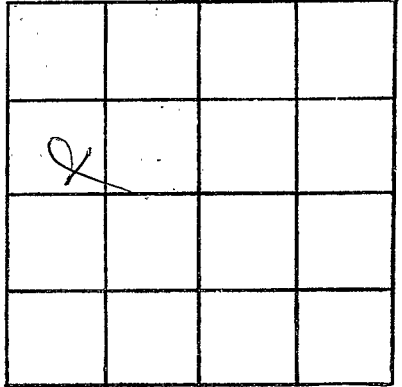

SECTION 18

Please indicate well location X.

ADDITIONAL INFORMATION

If more than one screen,
show locations of each on sketch.