

Tippah
Φ 8
4-67

MISSISSIPPI
 BOARD OF WATER COMMISSIONERS
 416 North State Street
 Jackson, Mississippi 39201

CODED

WATER WELL DRILLERS LOG

April 20 19 67 Jumpstart Well Co Tippah
 date well completed firm name county well located

LANDOWNER: _____
Wilson, Gary

 (mailing address)

description of formations encountered	from	to
<u>red sandstone</u>	<u>0</u>	<u>100</u>
<u>clay</u>		

WELL LOCATION:
 sec 18 T 5 N R 4 E
 S _____ E
1.6 miles east of Blue Springs
 (distance) (direction) (nearest town)


<u>red sandstone</u>	<u>100</u>	<u>180</u>
<u>rock</u>		

WELL PURPOSE: drinking
 (home, irrigation, municipal, industrial)

WELL COMPLETION DATA:

- (1) diameter (inches) 4
- (2) total depth (feet) 180
- (3) static water level (feet) 90 below top of ground.
- (4) casing PVC, 180
 (material), (depth)
_____ if telescope see back.
 (size)
- (5) screen 19, 160
 (length), (depth to top)
3/8, galval
 (size), (material)
- (6) pump 4, 60
 (HP), (yield gpm)
electricity
 (type power)
- (7) electric log NO
 (yes or no)
UES
 (organization running log)
- (8) how well bottom plugged PVC cap

CODED

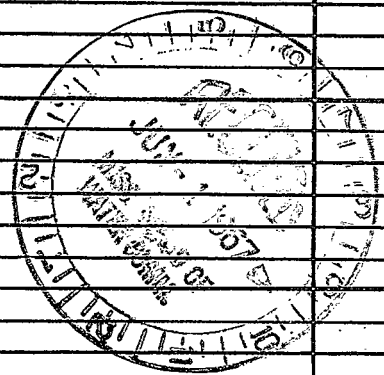

DRILLERS REMARKS: _____

If well telescopes please sketch and show depths.

GROUND LEVEL

SECTION _____

Please indicate well location X.

ADDITIONAL INFORMATION

If more than one screen,
show locations of each on sketch.