

TIPPAM  
 09  
 11-16-70

MISSISSIPPI  
 BOARD OF WATER COMMISSIONERS  
 416 North State Street  
 Jackson, Mississippi 39201

**CODED**

WATER WELL DRILLERS LOG

11-16-1970 date well completed  
 J.T. Medlin firm name  
 Tippah county well located

LANDOWNER: L.H. Walker  
 Ripley Miss  
 (mailing address)

WELL LOCATION:  
 sec. 25 T 5 N R 4 E  
 4 miles S of Dumas  
 (distance) (direction) (nearest town)

WELL PURPOSE:  
 (home, irrigation, municipal, industrial)

- WELL COMPLETION DATA:
- (1) diameter (inches) 4
  - (2) total depth (feet) 120
  - (3) static water level (feet) 73 below top of ground.
  - (4) casing P 120 (material) (depth)  
 (size) if telescope see back.
  - (5) screen 40 80 (length) (depth to top)  
 4 P (size) (material)
  - (6) pump 1/2 4 (HP) (yield gpm)  
 E (type power)
  - (7) electric log (yes or no)  
 (organization running log)
  - (8) how well bottom plugged Blue Clay

description of formations encountered	from	to
Red Clay	0	9
" Sand	9	27
Yellow Clay	27	36
Sand	36	41
Rock	41	49
Sand	49	53
Blue	53	61
Sand	61	65
Rock	65	64
Sand	64	110
Blue	110	120


**CODED**

DEC 3 1970

DRILLERS REMARKS:

If well telescopes please sketch and show depths.

GROUND LEVEL

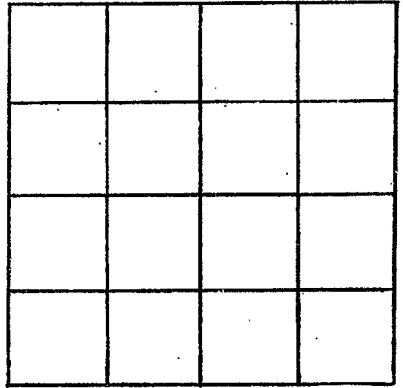

SECTION \_\_\_\_\_

Please indicate well location X.

ADDITIONAL INFORMATION

If more than one screen,  
show locations of each on sketch.